IREDELL COUNTY HEALTH DEPARTMENT

STATESVILLE 704-878-5305 MOORESVILLE 704-664-5281 (4)

IMPROVEMENT PERMIT / AUTHORIZATION TO CONSTRUCT / OPERATION PERMIT / EXISTING SYSTEM INSPECTION

PERMIT# 12123 PIN# 4775-10-1613 DATE

OWNER OR CONTRACTOR LARRY P. MURRAY PHONE: Business Home 704-872-6019

ADDRESS 145 VERNA DRIVE, STATESVILLE, NC 28625

LOCATION US 64 EAST, TR NEW SALEM ROAD, TR LYNNGAYLE, TL VERNA LAST ON LEFT

SUBDIVISION CAMPBELL GLEN BLOCK / SECTION LOT 20/21 LOT AREA LIMITED0.62 SITE CLASS. PS DESIGN FLOW 360 L.T.A.R. 0.30 GPD/FT²

Septic Tank: 1000 Gallons; STB 1012 Date 5-3-00

Pump Tank: 1000 Gallons; PT 17 Date 1-22-2000

Pump Make: GOULDS Model WE0511 Serial No. G000 7466

Nitrification Field: No Fields 1 Square Feet EQ TO 1200 Linear Feet 300

No Lines FOUR Trench Width 36" Max Trench Bottom Depth 36" Gravel Depth N/A

☐ New System ☐ Repair System Type: I, II, (III), IV, V, VI

System Description: 25% REDUCTION, PUMP

Repair System Description: 50% REDUCTION FLOW - PRESSURE

Maintenance Agreement Required: ☐ Yes ☒ No

☒ House/Mod. Home No. Bedrooms 3

☐ Mobile Home No. Bathrooms 3

☐ Business No. Employees

☐ Other


☐ Slab ☑ Crawl Space ☐ Basement w/plumbing ☐ Basement wo/plumbing

Water Supply: ☐ Individual ☒ Public ☐ Community


Comments:/Conditions:

Comments:/Conditions:

INITIAL SITE SKETCH

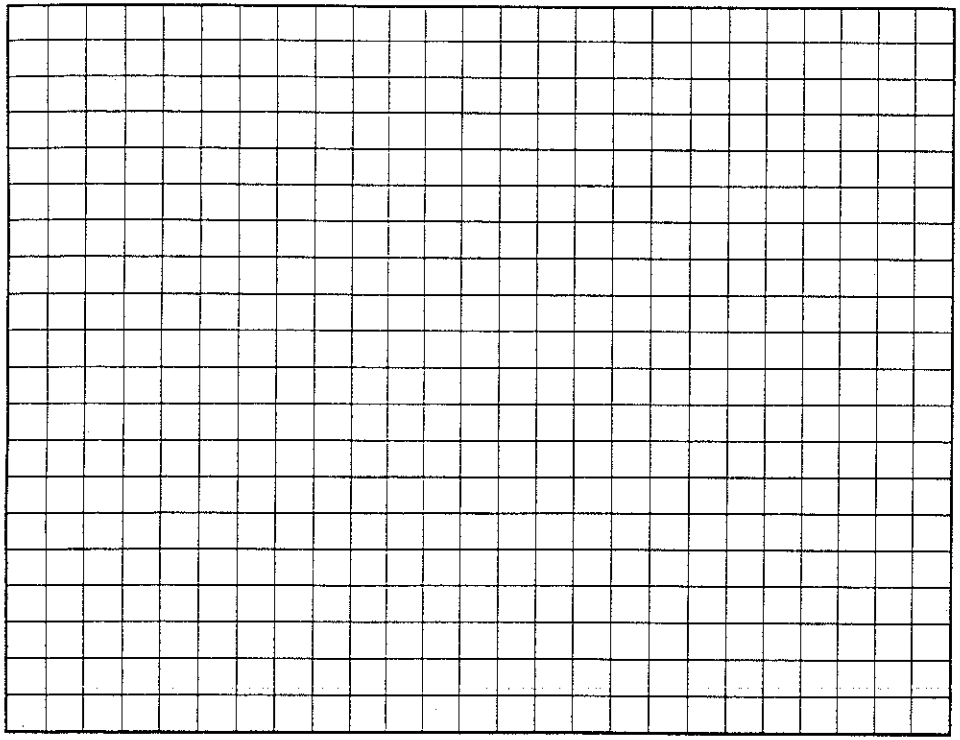

AS BUILT SKETCH

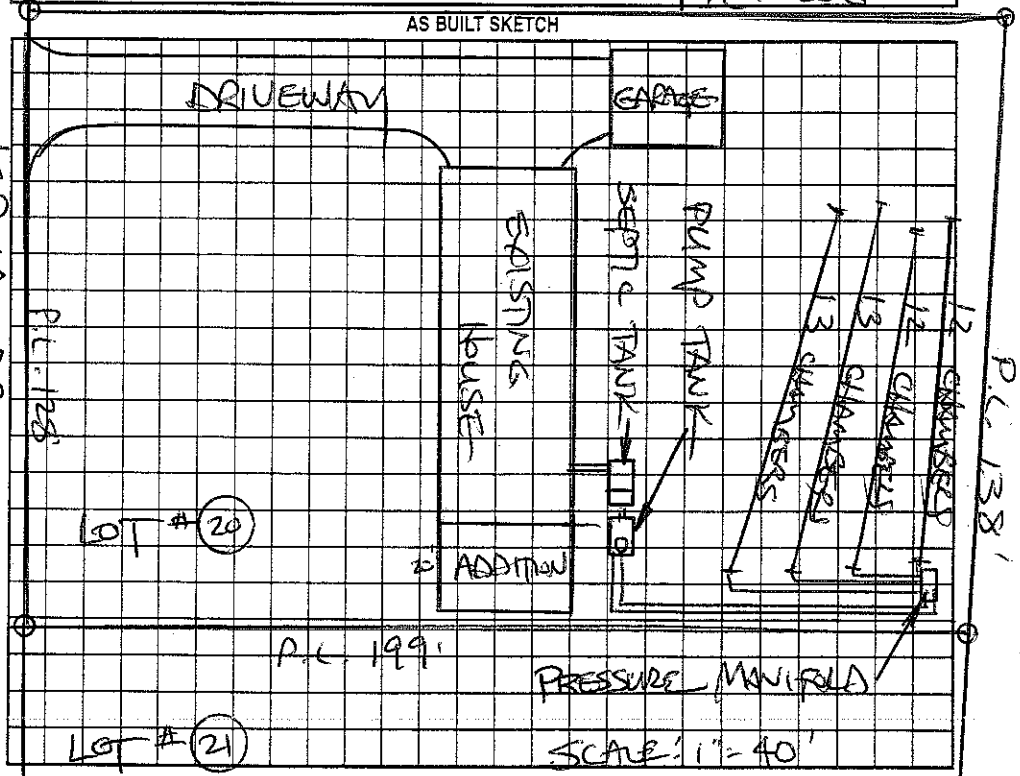

Permit can be suspended or revoked if any false information is supplied toward securing the permit/any unauthorized changes are made to the site/any unauthorized changes are made in the installation of the system. Improvement Permit with plat valid without expiration. Improvement Permit with site plan valid for sixty months. Authorization to Construct is valid for a period equal to that of Improvement Permit – not to exceed sixty months.

Signed: _____ date _____ Installed by: _____

Improvement Permit by: _____ date _____ Operation Permit by: _____ date _____

Authorization to Construct by: _____ date _____ Existing System Inspection by: STEVE HENDRICK date 5-11-04

HEALTH DEPT. COPY: WHITE OWNER COPY (FINAL): YELLOW OWNER COPY (INITIAL): PINK