IREDELL COUNTY HEALTH DEPARTMENT

STATESVILLE 704-878-5305 MOORESVILLE 704-664-5281

IMPROVEMENT PERMIT / AUTHORIZATION TO CONSTRUCT / OPERATION PERMIT / EXISTING SYSTEM INSPECTION

PERMIT# 72193 PIN# 4775-10-3317 DATE 3-11-98

OWNER OR CONTRACTOR Todd A. Stroud PHONE: Business Home 872-0814

ADDRESS 2515 Cliffside Drive Statesville

LOCATION 64E TR New Salem ch Rd at corner of Pottery Rd

SUBDIVISION Campbell Glenn BLOCK / SECTION LOT 1 LOT AREA 1.19 acres SITE CLASS PS DESIGN FLOW 480 L.T.A.R. .28

Septic Tank: 1000 Gallons; STB 1012 Date 3-12-98
Pump Tank: Gallons; PT Date
Pump Make: Model Serial No.
Nitrification Field: No Fields 1 Square Feet 1800 Linear Feet 600
No Lines 4 Trench Width 36" Max Trench Bottom Depth 36" Gravel Depth 12"

☑ New System ☐ Repair System Type: I, II, III, IV, V, VI
System Description: Conv. Gravity
Repair System Description: Gravity Chamber or HDPE
Maintenance Agreement Required: ☐ Yes ☑ No


☑ House/Mod. Home No. Bedrooms 4
☐ Mobile Home No. Bathrooms 3
☐ Business No. Employees
☐ Other
☐ Slab ☑ Crawl Space ☐ Basement w/plumbing ☐ Basement wo/plumbing

Water Supply: ☐ Individual ☑ Public ☐ Community

Comments:/Conditions:

Comments:/Conditions:

INITIAL SITE SKETCH

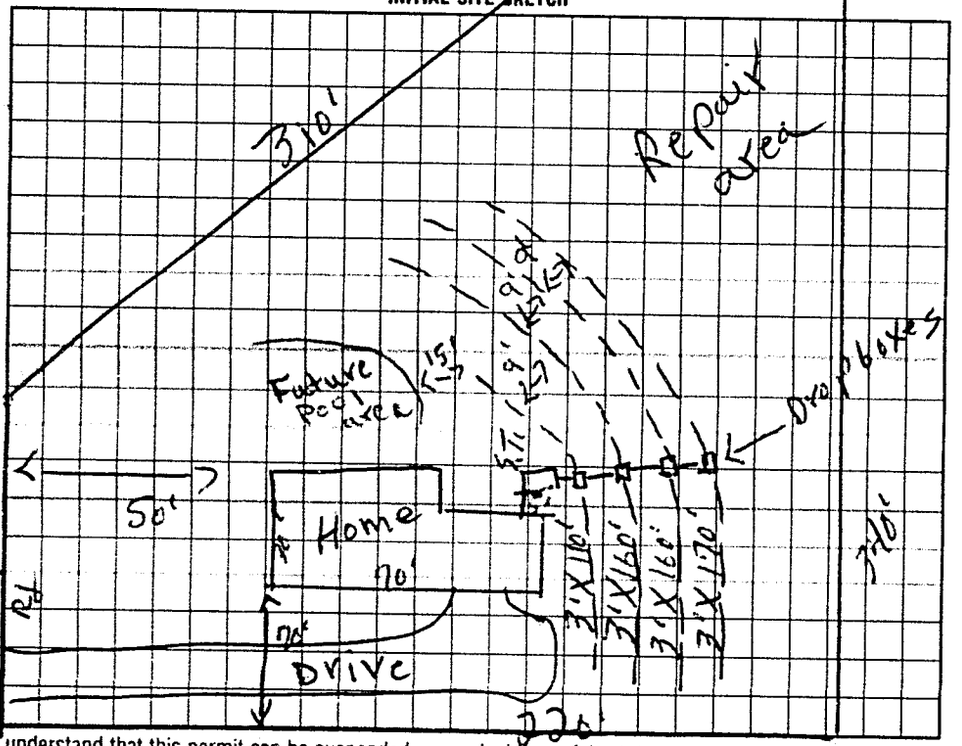

AS BUILT SKETCH

Installed as shown

I understand that this permit can be suspended or revoked if any false information is supplied toward securing the permit/any unauthorized changes are made to the site/any unauthorized changes are made in the installation of the system. Improvement Permit with plat valid without expiration. Improvement Permit with site plan valid for sixty months. Authorization to Construct is valid for a period equal to that of Improvement Permit – not to exceed sixty months.

Signed: Todd Stroud date

Improvement Permit by: P.C. Moore date 3-11-98

Authorization to Construct by: P.C. Moore date 3-11-98

Installed by: David Yountz

Operation Permit by: Mat C. Off PS date 10-13-98

Existing System Inspection by date

HEALTH DEPT COPY (WHITE) INSPECTION COPY (FINAL) GREEN OWNER COPY (FINAL) YELLOW INSPECTION COPY (INITIAL) PINK OWNER COPY (INITIAL) GOLD