IREDELL COUNTY HEALTH DEPARTMENT

STATESVILLE 704-878-5305 MOORESVILLE 704-664-5281

IMPROVEMENT PERMIT / CERTIFICATE OF COMPLETION / OPERATION PERMIT / EXISTING SYSTEM INSPECTION

PROPERTY DESCRIPTION NO. 68414 DATE 8-27-97 TAX MAP NO. 4775 10 3657 Watershed: ☐ Yes ☐ No

OWNER OR CONTRACTOR W & W Sales PHONE: Business _____ Home 876 6083

ADDRESS PO Box 5792 Sta.

LOCATION 64E TR New Salem ch Rd on Rt after Pops Lake Rd

SUBDIVISION Campbell Glenn BLOCK / SECTION _____ LOT 3 LOT AREA 138' X 230 SITE CLASS. PS DESIGN FLOW 360 L.T.A.R. .13

Septic Tank: 1000 Gallons; STB 1012 Date 1-7-98

Pump Tank: _____ Gallons; PT _____ Date _____

Pump Make: _____ Model _____ Serial No. _____

Nitrification Field: No Fields 1 Square Feet 1200 Linear Feet 400

No Lines 3 Trench Width 36" Max Trench Bottom Depth 36" Gravel Depth 12"

☑ New System ☐ Repair System Type: I, II, III, IV, V, VI

System Description: Conv. Gravity

Repair System Description: _____

Maintenance Agreement Required: ☐ Yes ☑ No

☑ House/Mod. Home No. Bedrooms 3

☐ Mobile Home No. Bathrooms 2

☐ Business No. Employees _____

☐ Other _____

☐ Slab ☑ Crawl Space ☐ Basement w/plumbing ☐ Basement wo/plumbing


Water Supply: ☐ Individual ☐ Community ☑ Public

Comments:


Replaces Permit Issued 7-26-97 lot size Reduced Due To New Road placement.

Comments:

INITIAL SITE SKETCH

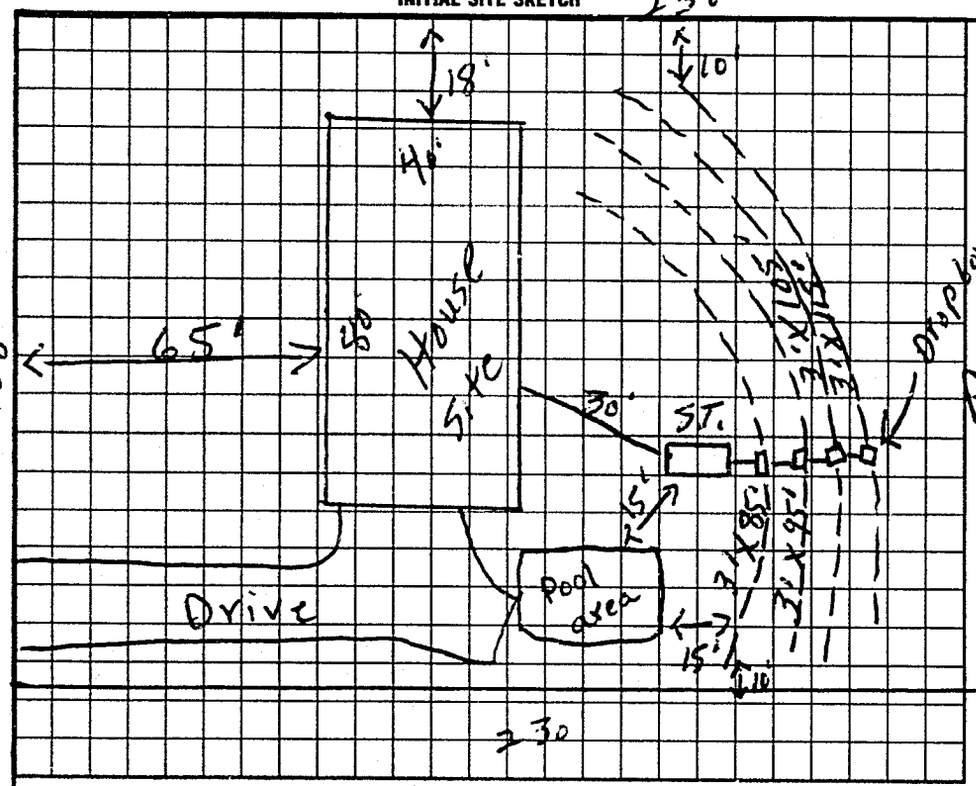

AS BUILT SKETCH

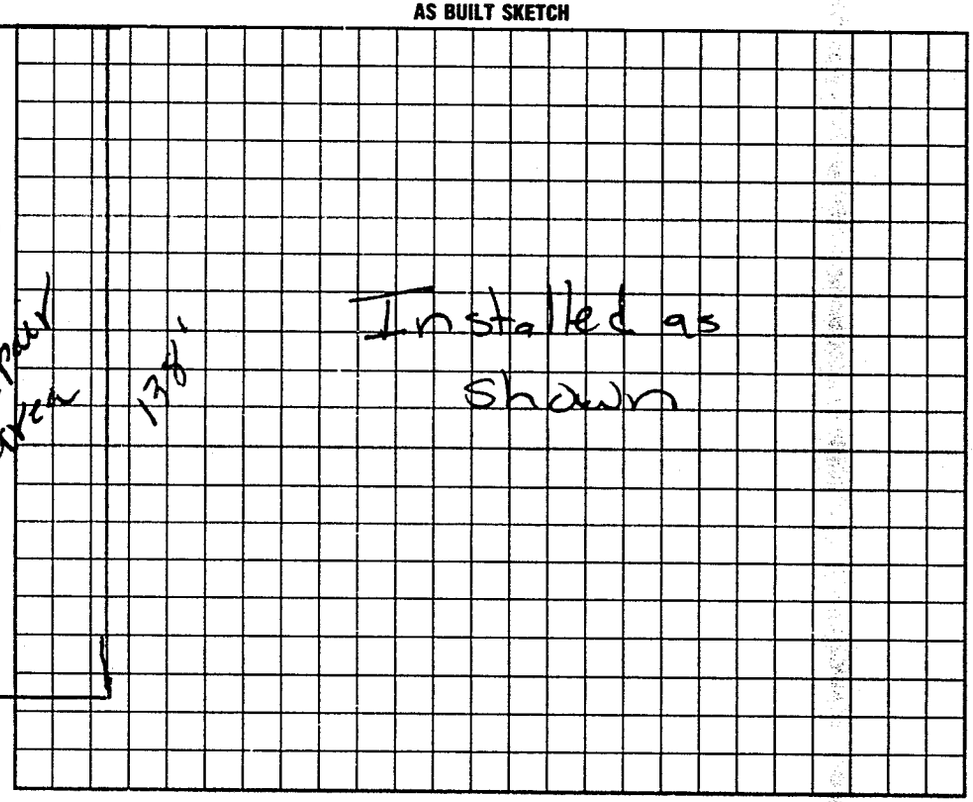

I understand that this permit can be suspended or revoked if any false information is supplied toward securing the permit/any unauthorized changes are made to the site/any unauthorized changes are made in the installation of the system. Improvement Permit is valid for 60 months from date of issuance.

Signed: _____

Improvement Permit by: R.C. Moore date 8-27-97

Authorization to Existing System Inspection by: R.C. Moore date 8-27-97

Authorization to count.

Installed by: David Yountz

Certificate of Completion by: _____ date _____

Operation Permit by: Matt Outlaw date 5-29-98

HEALTH DEPT. COPY WHITE | INSPECTION COPY (FINAL) GREEN | OWNER COPY (FINAL) YELLOW | INSPECTION COPY (INITIAL) PINK | OWNER COPY (INITIAL) GOLD

Authorization to count. Expires 60 mos from issue