IREDELL COUNTY HEALTH DEPARTMENT

STATESVILLE 704-878-5305 MOORESVILLE 704-664-5281

IMPROVEMENT PERMIT / AUTHORIZATION TO CONSTRUCT / OPERATION PERMIT / EXISTING SYSTEM INSPECTION

PERMIT# 83775 PIN# 4775111032 DATE 9-15-99

OWNER OR CONTRACTOR Danny Lippard Jr. PHONE: Business 528 1107 Home

ADDRESS 144 Buffaloway Statesville, N.C.

LOCATION 64E Rt New Salem TR Lynn Gayle TL Verna 2nd lot left

SUBDIVISION Campbell Glenn BLOCK / SECTION 2 LOT 17 LOT AREA .66 SITE CLASS PS DESIGN FLOW 360 L.T.A.R. .27

Septic Tank: 1000 Gallons; STB 1012 Date 4-9-00

Pump Tank: Gallons; PT Date

Pump Make: Model Serial No.

Nitrification Field: No Fields 1 Square Feet 1350 Linear Feet 450

No Lines 6 Trench Width 36" Max Trench Bottom Depth 24" Gravel Depth 12"

☑ New System ☐ Repair System Type: I (II) III IV V VI

System Description: Conv. Gravity

Repair System Description: Gravity 25% Rdn.

Maintenance Agreement Required: ☐ Yes ☑ No

☐ Slab ☑ Crawl Space ☐ Basement w/plumbing ☐ Basement wo/plumbing

☑ House/Mod. Home No. Bedrooms 3

☐ Mobile Home No. Bathrooms 2

☐ Business No. Employees


☐ Other

Water Supply: ☐ Individual ☑ Public ☐ Community


Comments/Conditions:

Comments/Conditions

INITIAL SITE SKETCH

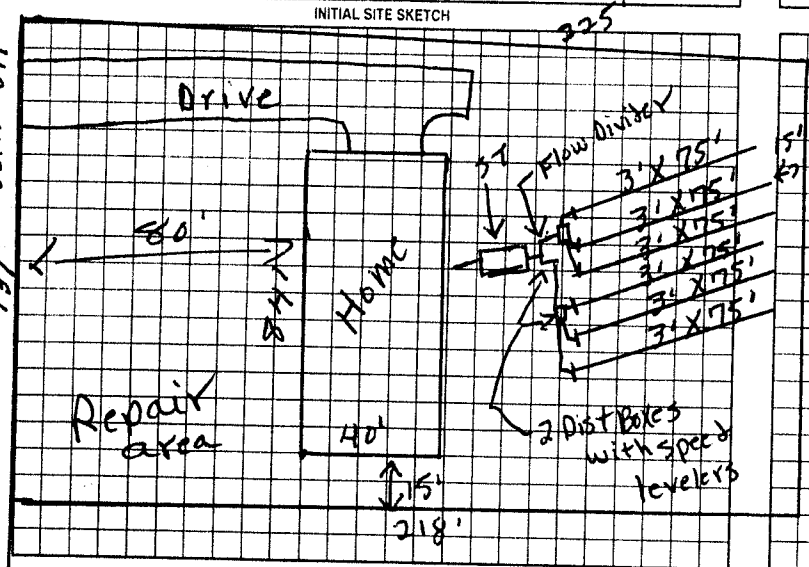

AS BUILT SKETCH

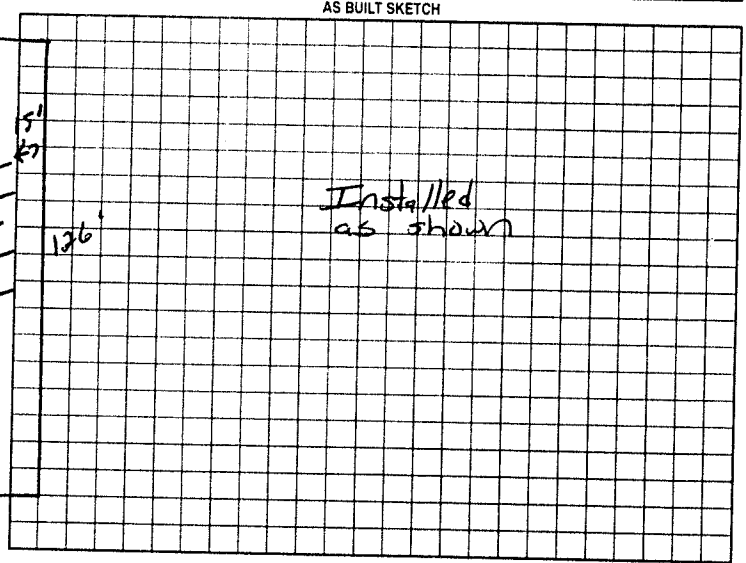

Permit can be suspended or revoked if any false information is supplied toward securing the permit/any unauthorized changes are made to the site/any unauthorized changes are made in the installation of the system. Improvement Permit with plat valid without expiration. Improvement Permit with site plan valid for sixty months. Authorization to Construct is valid for a period equal to that of Improvement Permit – not to exceed sixty months.

Signed: Bridgett & Lippard date 10-5-99 Installed by: David Yountz

Improvement Permit by: F. C. Moore date 9-15-99 Operation Permit by: Mat Coffey date 5-23-00

Authorization to Construct by: F. C. Moore date 9-15-99 Existing System Inspection by: date

HEALTH DEPT. COPY: WHITE OWNER COPY (FINAL): YELLOW OWNER COPY (INITIAL): PINK