IREDELL COUNTY HEALTH DEPARTMENT

Statesville Office (704) 878-5305 Mooresville Office (704) 660-3625 PERMIT # 180784

IMPROVEMENT PERMIT / AUTHORIZATION TO CONSTRUCT / OPERATION PERMIT / EXISTING SYSTEM

PIN # 4775111032

APPLICANT: Edward Pack APPLICANT ADDRESS: 129 Verna Dr.

SITE ADDRESS: 129 Verna Dr. PHONE: 704-761-8446 ALT. PHONE: 503-702-4755

SITE DIRECTIONS: Hwy 64E TR New Salem Rd. TR Lyngale TL Verna Dr.


SUBDIVISION: Campbell Glenn SECTION: N/A LOT # 17 LOT AREA: .66 acres DESIGN FLOW: 360gpd L.T.A.R.: Existing

Septic Tank	Existing	(gal)	STB		Date		☐ New System	☐ Repair	☐ Expansion	System Type: I ☑ II III IV V VI	☑ Residence	No. Bedrooms	3	Water Supply
Pump Tank		(gal)	PT		Date		System Description:	Conventional			☐ Business	No. Persons		☐ Private
Pump Make			Model		Serial #		Repair System Description:				☐ Other	No. Employees		☑ Public
# Nitrification Fields	1		# Lines	6	Linear Ft:	Ex	Maintenance Agreement Required:	☐ YES	☑ NO		☐ Slab	☑ Crawl Space		☐ Community
Trench Width	Ex		Max. Trench Bottom Depth	Ex	Gravel Depth	Ex		☑ GRAVITY	☐ PRESSURE		☐ Basement w/ plumbing		☐ Basement w/o plumbing	


Comments / Conditions:

- Maintain a minimum of 5' between out-building foundation & all components of septic system.
- Maintain a minimum of 15' between pool & septic system; - Maintain 5' between pool deck & septic system

INITIAL SITE SKETCH

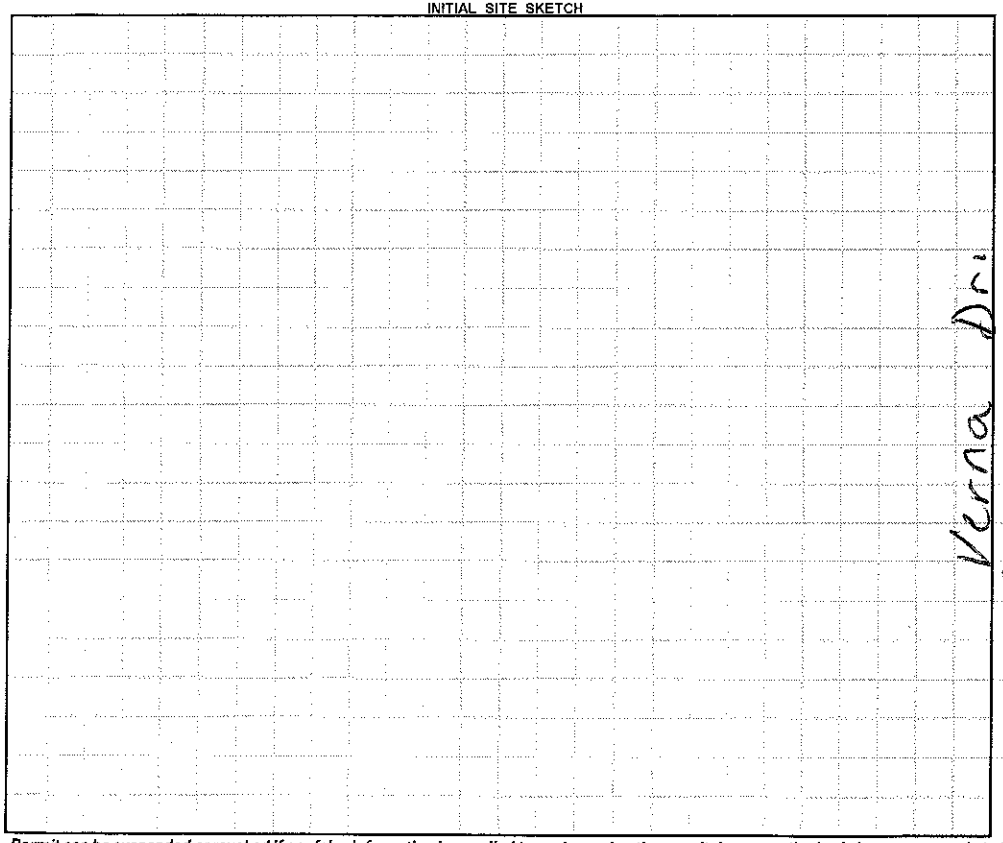

AS BUILT SKETCH

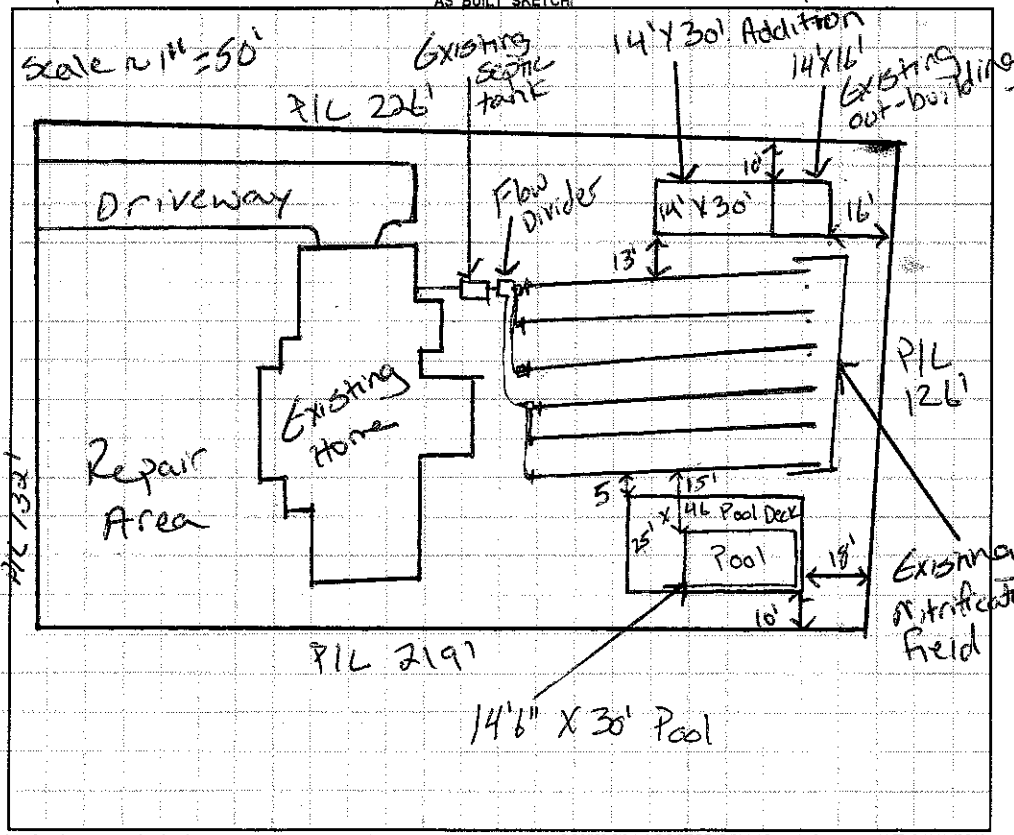

Permit can be suspended or revoked if any false information is supplied toward securing the permit / any unauthorized changes are made to the site / any unauthorized changes are made in the installation of the system. **CONTACT A LOCATOR SERVICE PRIOR TO ANY EXCAVATION**

☐ **IMPROVEMENT PERMIT** *with plat valid without expiration.* ☐ **IMPROVEMENT PERMIT** *with site plan valid for 60 mos.* ☐ **AUTHORIZATION TO CONSTRUCT** *valid for period equal to IMPROVEMENT PERMIT--not to exceed 60 mo.*

Owner / Applicant Signature: Edward Pack Date: 10-2-13 Installed by:

IMPROVEMENT PERMIT by: Date: OPERATION PERMIT by: Date:

AUTHORIZATION TO CONSTRUCT by: Date: Existing System Inspected by: Justin Henderson Date: 9-27-13

Health Dept. Copy - WHITE Applicant (Final Approval) - YELLOW Applicant (Conditional Approval) - PINK