IREDELL COUNTY HEALTH DEPARTMENT

STATESVILLE 704-878-5305 (C) MOORESVILLE 704-664-5281

IMPROVEMENT PERMIT / AUTHORIZATION TO CONSTRUCT / OPERATION PERMIT / EXISTING SYSTEM INSPECTION

PERMIT# 111324 PIN# 4775-11-1468 PAGER 704-923-3611 DATE 03-21-03

OWNER OR CONTRACTOR ERIC PATTERSON PHONE: Business 704-873-9717 Home 704-881-0845

ADDRESS 115 FRIENDLY CIRCLE STATESVILLE NC 28625

LOCATION 64 EAST (R) NEW SALEM (R) LYNN GAYLE, (R) VERNA, ON RT IN (UL-DE-SAC

SUBDIVISION CAMPBELL GLEN BLOCK / SECTION 2 LOT 14 LOT AREA .64AC SITE CLASS. PS DESIGN FLOW 360 L.T.A.R. .25

Septic Tank: 1000 Gallons; STB 1007 Date 9-3-03
Pump Tank: ____ Gallons; PT ____ Date ____
Pump Make: ____ Model ____ Serial No. ____
Nitrification Field: No Fields 1 Square Feet EQ/1440 Linear Feet 360'
No Lines 5 Trench Width 36" Max Trench Bottom Depth 32-36" Gravel Depth N/A

[X] New System [ ] Repair System Type: I, II, (III) IV, V, VI
System Description: 6 RAY 2510 PRODUCT
Repair System Description: LP PANEL
Maintenance Agreement Required: [ ] Yes [X] No


[X] House/Mod. Home No. Bedrooms 3
[ ] Mobile Home No. Bathrooms 2
[ ] Business No. Employees ____
[ ] Other ____
[ ] Slab [X] Crawl Space [ ] Basement w/plumbing [ ] Basement wo/plumbing

Water Supply: [ ] Individual [X] Public [ ] Community


Comments:/Conditions: (1) INSTALL LINES A MINIMUM OF 32" DEEP & A MAXIMUM OF 36" DUE TO BETTER SOIL STRUCTURE. (2) MAINTAIN STUBOUT OUT 6" ABOVE NATURAL GRADE & BAFFLE TO MAINTAIN A GRAVITY SYSTEM.

Comments:/Conditions: (3) INSTALL LINES ON CONTOUR & MAINTAIN SETBACKS. (4) SYSTEM & HOUSE IS FLAGGED OUT & STAKED OUT. THE HOUSE HAS SHIFTED TO 26' OFF RIGHT P/L AS DRAWN

INITIAL SITE SKETCH 1" ≈ 50'

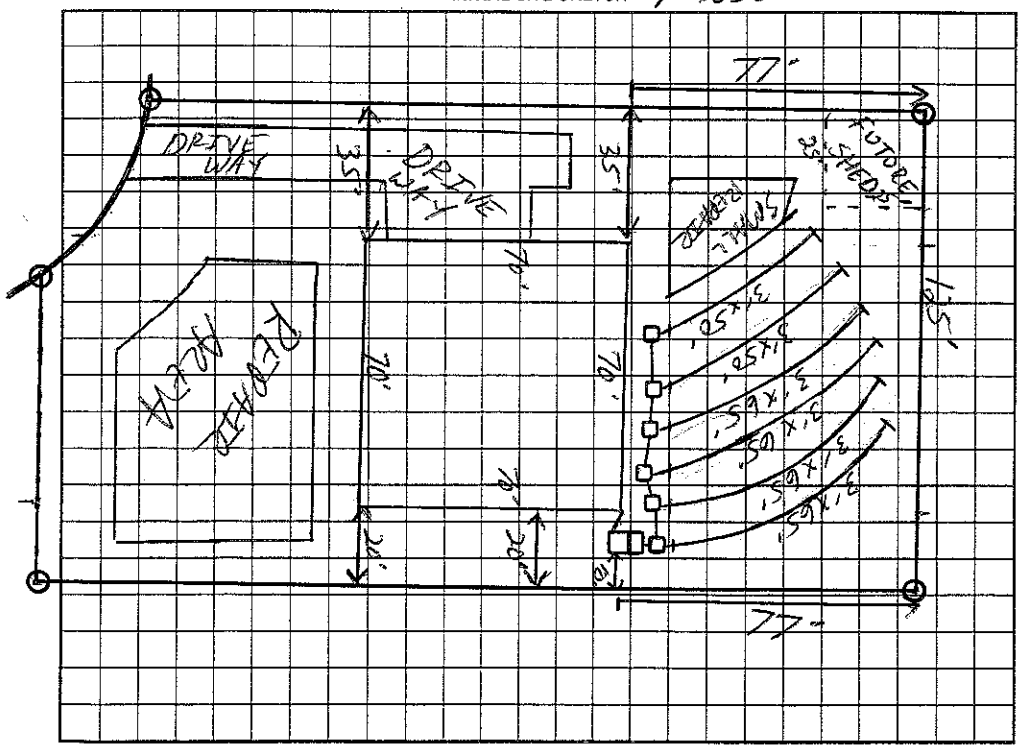

AS BUILT SKETCH

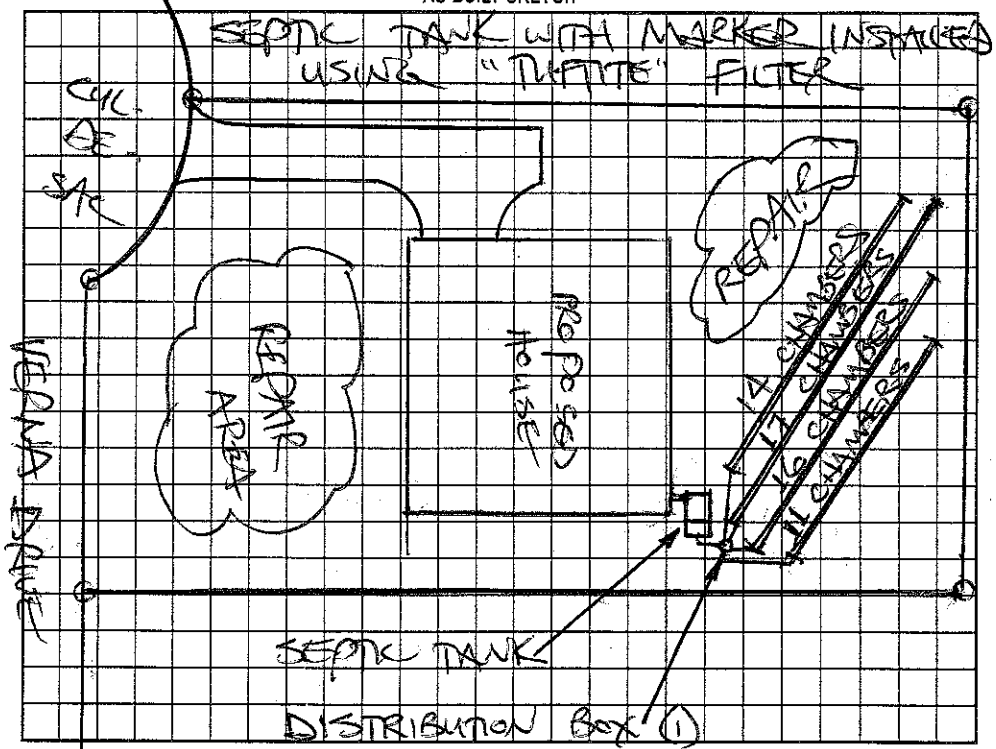

Permit can be suspended or revoked if any false information is supplied toward securing the permit/any unauthorized changes are made to the site/any unauthorized changes are made in the installation of the system. Improvement Permit with plat valid without expiration. Improvement Permit with site plan valid for sixty months. Authorization to Construct is valid for a period equal to that of Improvement Permit – not to exceed sixty months.

Signed: Elizabeth Patterson date 3-21-03

Improvement Permit by: [signature] RS date 03-21-03

Authorization to Construct by: [signature] RS date 03-21-03

Installed by: JAMES HUDLER

Operation Permit by: STEVE HENDRICK date 10-23-03

Existing System Inspection by: ____ date ____

HEALTH DEPT. COPY: WHITE OWNER COPY (FINAL): YELLOW OWNER COPY (INITIAL): PINK