IREDELL COUNTY HEALTH DEPARTMENT

STATESVILLE 704-878-5305 MOORESVILLE 704-664-5281

IMPROVEMENT PERMIT / AUTHORIZATION TO CONSTRUCT / OPERATION PERMIT / EXISTING SYSTEM INSPECTION

PERMIT# 76005 PIN# 4775 10 0706 DATE 8-31-98

OWNER OR CONTRACTOR Robin Gettys PHONE: Business Home 873-3571

ADDRESS 282 Sain Rd Sta.

LOCATION 64E TR New Salem ~ 1/2mi TR Verna Dr N at end

SUBDIVISION Campbell Glenn BLOCK / SECTION LOT 12 LOT AREA 1.18 acres SITE CLASS. PS DESIGN FLOW 480 L.T.A.R. 13

Septic Tank: 1000 Gallons; STB 183 Date 2-12-99
Pump Tank: Gallons; PT Date
Pump Make: ~~Hydromatic~~ Model SPO~~Geon~~ Serial No. ~~Structural~~
Nitrification Field: No Fields 1 Square Feet 1600 Linear Feet 533
No Lines 4 Trench Width 36" Max Trench Bottom Depth 36" Gravel Depth 12"

[ ] New System [ ] Repair System Type: I, II, III, IV, V, VI
System Description: Conv. Gravity
Repair System Description: Gravity 25% Red.
Maintenance Agreement Required: [ ] Yes [X] No


[X] House/Mod. Home No. Bedrooms 4
[ ] Mobile Home No. Bathrooms 3
[ ] Business No. Employees
[ ] Other
[ ] Slab [ ] Crawl Space [ ] Basement w/plumbing [ ] Basement wo/plumbing

Water Supply: [ ] Individual [X] Public [ ] Community


Comments:/Conditions: 253'

Comments:/Conditions: K Note Tank set off Corner of house ~12ft

INITIAL SITE SKETCH

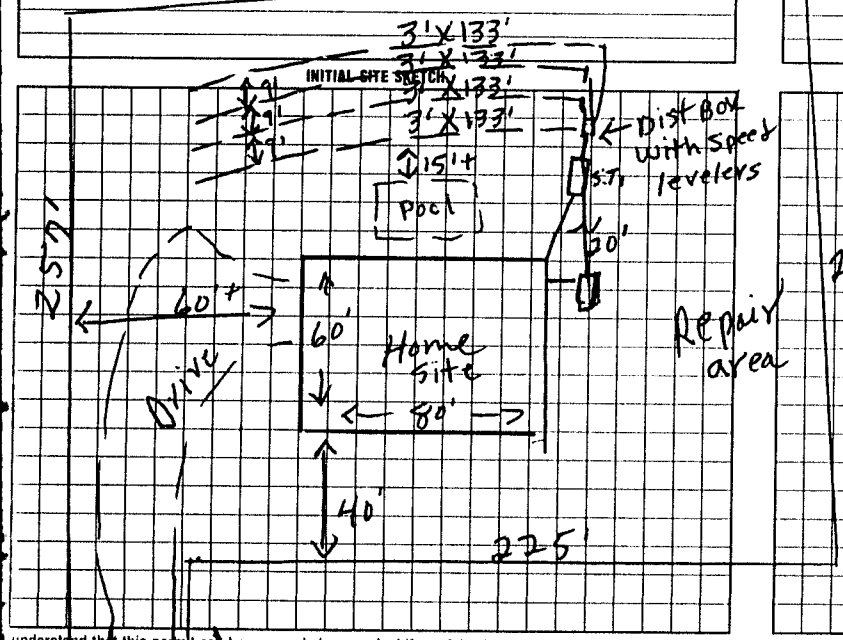

AS BUILT SKETCH

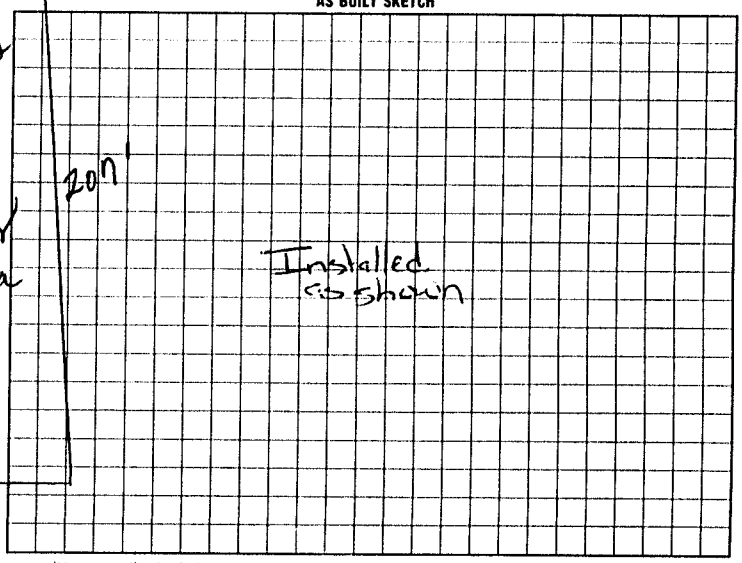

I understand that this permit can be suspended or revoked if any false information is supplied toward securing the permit/any unauthorized changes are made to the site/any unauthorized changes are made in the installation of the system. Improvement Permit with plat valid without expiration. Improvement Permit with site plan valid for sixty months. Authorization to Construct is valid for a period equal to that of Improvement Permit – not to exceed sixty months.

Signed: Robin Gettys date

Improvement Permit by: P. C. Moore date 8-31-98

Authorization to Construct by: P. C. Moore date 8-31-98

Installed by: David Miller Septic (Rowan) date

Operation Permit by: Mike Coffers date 3-18-99

Existing System Inspection by: date

HEALTH DEPT COPY: WHITE INSPECTION COPY (FINAL): GREEN OWNER COPY (FINAL): YELLOW INSPECTION COPY (INITIAL): PINK OWNER COPY (INITIAL): GOLD