IREDELL COUNTY HEALTH DEPARTMENT

STATESVILLE 704-878-5305 MOORESVILLE 704-664-5281

IMPROVEMENT PERMIT / CERTIFICATE OF COMPLETION / OPERATION PERMIT / EXISTING SYSTEM INSPECTION

PROPERTY DESCRIPTION NO. 67809 DATE 7-10-97 TAX MAP NO. 4775101869 Watershed: ☑ Yes ☐ No

OWNER OR CONTRACTOR Todd J. Ellis PHONE: Business 8786633 Home — WSIV PA

ADDRESS 178 meadow oak Dr. Statesville, N.C.

LOCATION 64E TR NewSalem Church Rd 1/2 mi rt

SUBDIVISION Campbell Glenn BLOCK / SECTION — LOT 3 LOT AREA 1.78 acres SITE CLASS. PS DESIGN FLOW 360 L.T.A.R. 1.3

Septic Tank: 1000 Gallons; STB 1012 Date 5-23-97
Pump Tank: — Gallons; PT — Date —
Pump Make: — Model — Serial No. —
Nitrification Field: No Fields 1 Square Feet 1200 Linear Feet 400
No Lines 3 Trench Width 36" Max Trench Bottom Depth 36" Gravel Depth 12"

☑ New System ☐ Repair System Type: I, II, III, IV, V, VI
System Description: Conv. Gravity
Repair System Description: " "
Maintenance Agreement Required: ☐ Yes ☑ No


☑ House/Mod. Home No. Bedrooms 3
☐ Mobile Home No. Bathrooms 2
☐ Business No. Employees —
☐ Other —
☐ Slab ☑ Crawl Space ☐ Basement w/plumbing ☐ Basement wo/plumbing

Water Supply: ☐ Individual ☐ Community ☑ Public


Comments:

Comments:

INITIAL SITE SKETCH

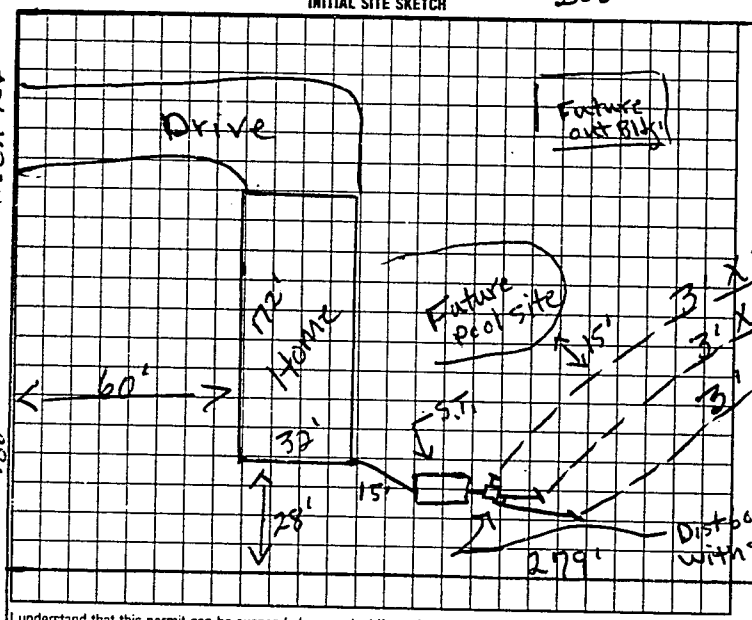

AS BUILT SKETCH

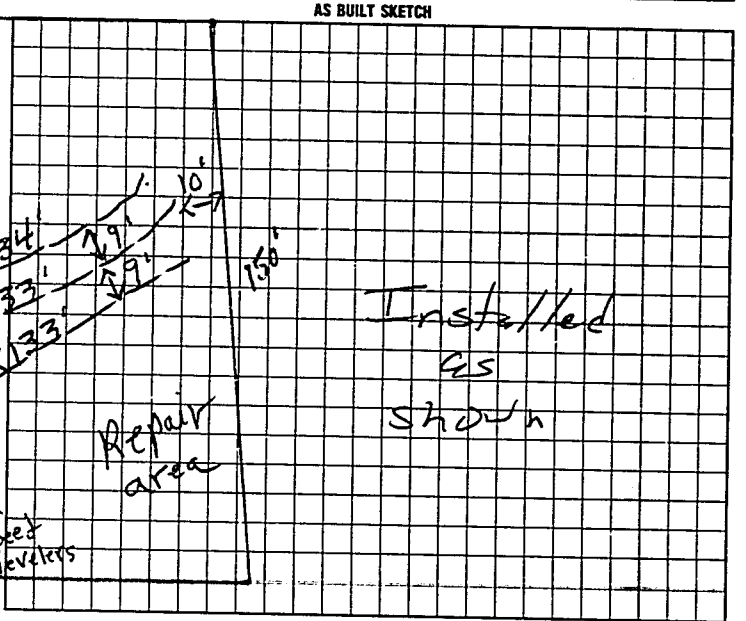

I understand that this permit can be suspended or revoked if any false information is supplied toward securing the permit/any unauthorized changes are made to the site/any unauthorized changes are made in the installation of the system. Improvement Permit is valid for 60 months from date of issuance.

Signed: —

Improvement Permit by: A. C. Moore date 7-10-97

Authorization to Existing System Inspection by: L. C. Moore date 7-10-97

to count.

Installed by: David Yountz

Certificate of Completion by: — date —

Operation Permit by Mark C. Oaks, RS date 11-21-97

Authorization to count. Expires 60 mos from issue

HEALTH DEPT. COPY-WHITE INSPECTION COPY (FINAL): GREEN OWNER COPY (FINAL): YELLOW INSPECTION COPY (INITIAL): PINK OWNER COPY (INITIAL): GOLD