IREDELL COUNTY HEALTH DEPARTMENT

Statesville Office (704) 878-5305 Mooresville Office (704) 660-3625

IMPROVEMENT PERMIT / AUTHORIZATION TO CONSTRUCT / OPERATION PERMIT / EXISTING SYSTEM

PERMIT # 20236 4

PIN # 4775114860

APPLICANT: Duke Carpenter

APPLICANT ADDRESS: 200 New Salem Rd.

SITE ADDRESS: 200 New Salem Rd

PHONE: 704-883-8881 ALT. PHONE: N/A

SITE DIRECTIONS: Hwy 64E TR New Salem Rd Property on R on Corner of New Salem & Pops Lake Rd.

SUBDIVISION: Cambell Glenn SECTION: 1 LOT # 11 LOT AREA: .189acres DESIGN FLOW: 480 L.T.A.R.: Existing

Septic Tank Ex (gal) STB Date

Pump Tank (gal) PT Date

Pump Make Model Serial #

Nitrification Fields 1 # Lines 5 Linear Ft: Ex

Trench Width Ex Max. Trench Bottom Depth Ex Gravel Depth Ex

☐ New System ☐ Repair ☐ Expansion System Type: I II (III) IV V VI

System Description: 25% Reduction

Repair System Description: 25% Reduction

Maintenance Agreement Required: ☐ YES ☑ NO

☑ GRAVITY ☐ PRESSURE

☑ Residence ☐ Business ☐ Other ☐ Slab ☐ Basement w/plumbing

No. Bedrooms 4 No. Persons 8 No. Employees Crawl Space

Water Supply: ☐ Private ☑ Public ☐ Community


☐ Basement w/o plumbing

Comments / Conditions:

- Maintain a minimum of 5' between Deck Addition & all components of septic tank system.

INITIAL SITE SKETCH

AS BUILT SKETCH

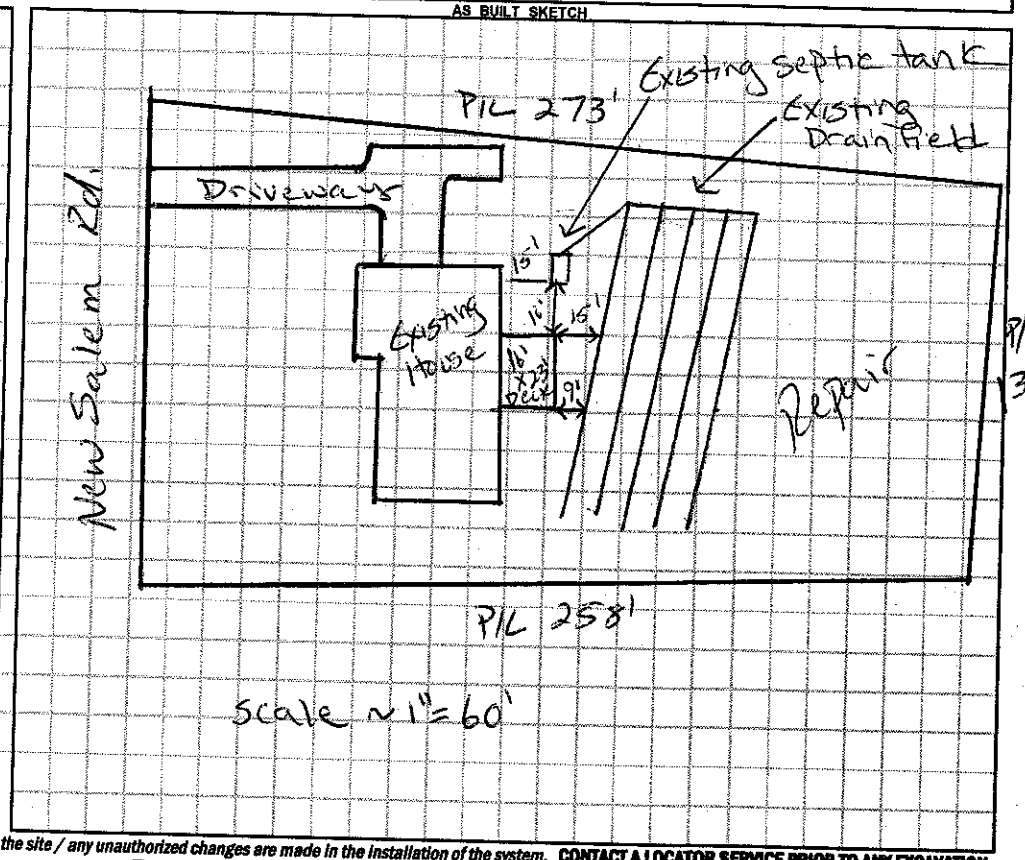

Permit can be suspended or revoked if any false information is supplied toward securing the permit / any unauthorized changes are made to the site / any unauthorized changes are made in the installation of the system. **CONTACT A LOCATOR SERVICE PRIOR TO ANY EXCAVATION**

☐ **IMPROVEMENT PERMIT *with plat*** *valid without expiration.* ☐ **IMPROVEMENT PERMIT *with site plan*** *valid for 60 mos.* ☐ **AUTHORIZATION TO CONSTRUCT** *valid for period equal to IMPROVEMENT PERMIT--not to exceed 60 mo.*

Owner / Applicant Signature: Duke Date: 4-14-14

IMPROVEMENT PERMIT by: Date:

AUTHORIZATION TO CONSTRUCT by: Date:

Installed by:

OPERATION PERMIT by: Date:

Existing System Inspected by: Justin Henderson Date: 4-11-14

Health Dept. Copy - WHITE Applicant (Final Approval) - YELLOW Applicant (Conditional Approval) - PINK