IREDELL COUNTY HEALTH DEPARTMENT

Statesville Phone TR 3-7271 Mooresville Phone No. 664-5281

PERMIT TO INSTALL SEPTIC TANK

Permit No. 727 Permit Date 10-10-73 19__

Owner Mr Powell (Joe Gantt Builder) Address Statesville N.C.

Installed By Raymond Adams Address Hiddenite N.C.


Location of Property 6 1/4 E. T.R. on Rd 2314 Salem Church Rd. House on L. Past Church.

Tank		Capacity		Length of Lines		Fixtures	
Block	( )	1000	(✓)	225'	( )	No. of Baths	(2)
Precast	(✓)	1250	( )	250'	( )	Dishwasher	(✓)
		1500	( )	Other 240		Garbage Grdr.	( )
		Other				Other	

NOTIFY HEALTH DEPARTMENT AT LEAST EIGHT HOURS BEFORE TANK IS TO BE INSPECTED.

Final Inspection 9-10 1973 Approved (✓) Disapproved ( )

Remarks Iredell Water Corp

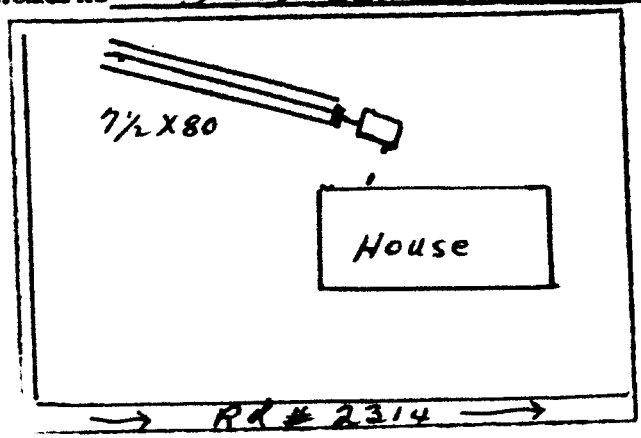

Sketch of Installation

E. G. Stevenson

Sanitarian