IREDELL COUNTY HEALTH DEPARTMENT - *ENVIRONMENTAL HEALTH* ☐ STATESVILLE OFFICE 704-878-5305 ☐ MOORESVILLE OFFICE 704-664-5281

IMPROVEMENT PERMIT / AUTHORIZATION TO CONSTRUCT / OPERATION PERMIT / EXISTING SYSTEM INSPECTION

PERMIT # 172582 PIN # 4775-11-7435 DATE May 29, 2012

OWNER Rufus & Julia Inman APPLICANT: Anthony & Sylvan Rousse PHONE: Home/Cell # 704-525-1106 Business #

SITE ADDRESS 217 New Salem Road OWNER / APPLICANT ADDRESS 217 New Salem Road, Stvl, NC 28625

SITE DIRECTIONS US 64 East, R New Salem Road, House on left at Box # 217


SUBDIVISION NA BLOCK / SECTION NA LOT # NA LOT AREA 1.143 Ac DESIGN FLOW NA L.T.A.R. NA

Septic Tank Ex	Gallons: STB	Date	☐ New System ☐ Repair ☐ Expansion System Type I ☐ II III IV V VI	☑ Residence	No. Bedrooms		Water Supply
Pump Tank	Gallons: P T	Date	System Description: Conventional, Gravity	☐ Business	No. Persons		☑ Private
Pump Make	Model	Serial #	Repair System Description:	☐ Other	No. Employees		☐ Public
No. Nitrification Fields: 1	No. Lines 1	Linear Feet 7½ x 80'	Maintenance Agreement Required ☐ YES ☑ NO	☐ Slab	☑ Crawl Space		☐ Community
Trench Width 7½	Max. Trench Bottom Depth Ex	Gravel Depth Ex	☑ GRAVITY ☐ PRESSURE	☐ Basement w/plumbing		☐ Basement w/o plumbing	


Comments / Conditions

Keep Pool minimum 15' from system.

INITIAL SITE SKETCH

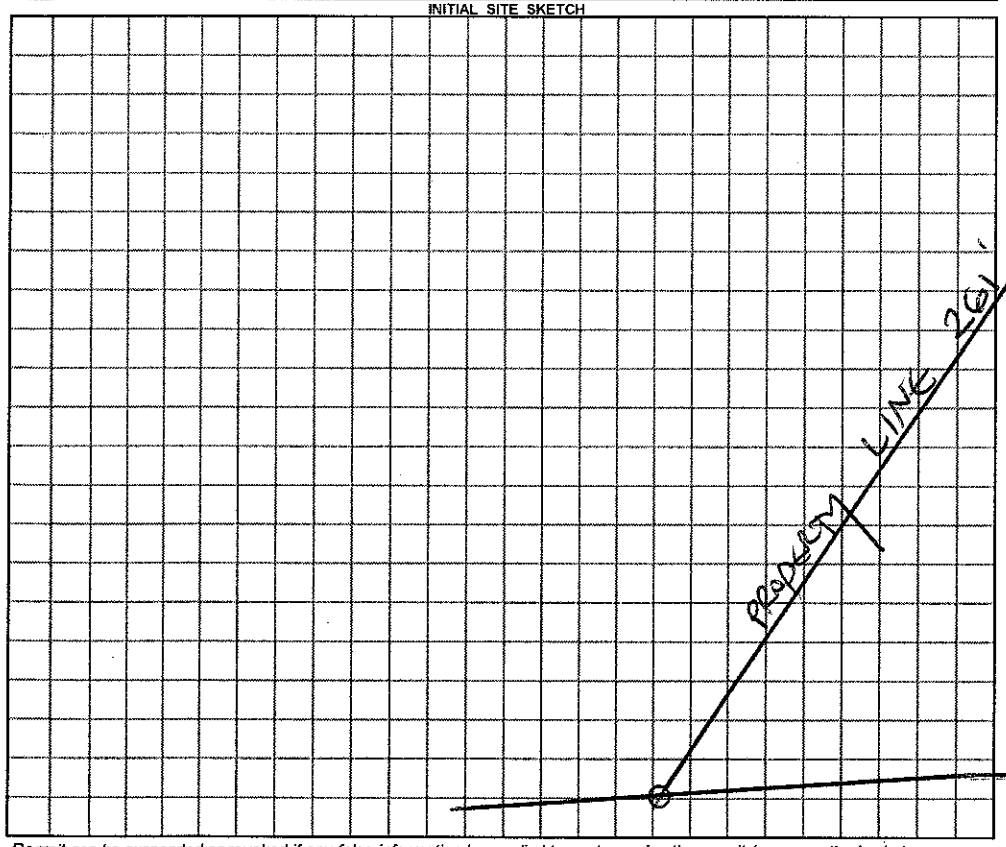

AS BUILT SKETCH

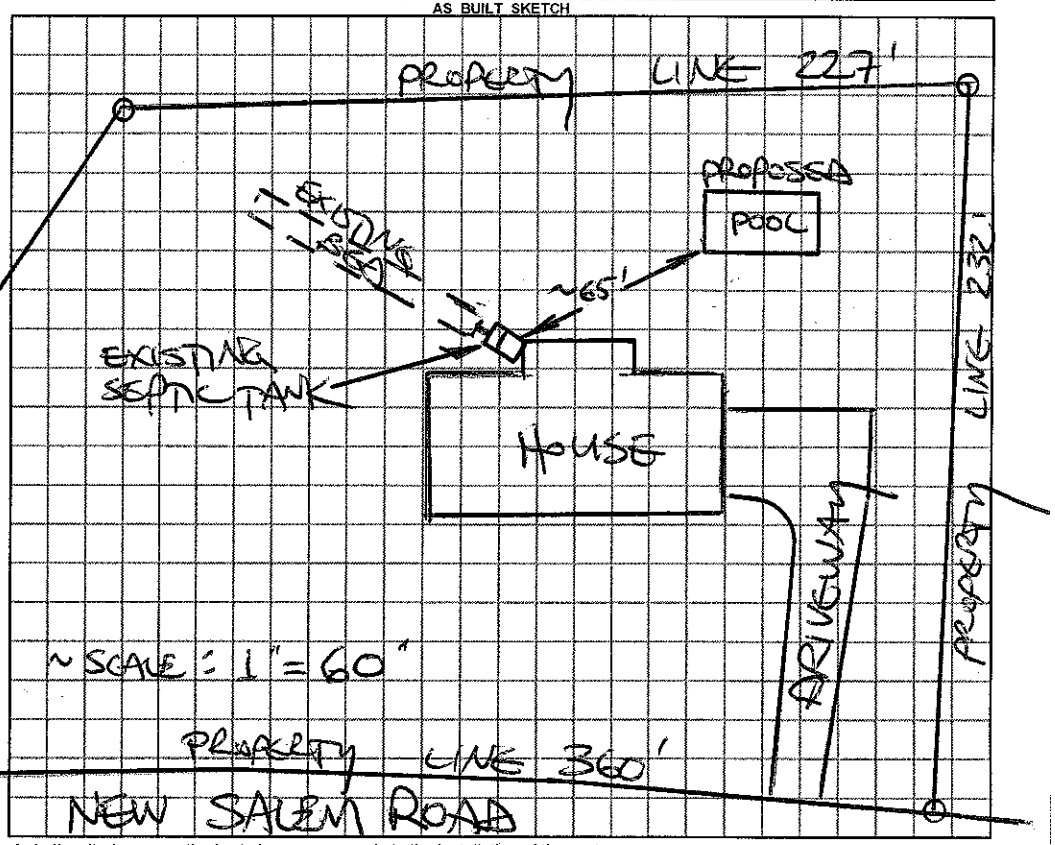

Permit can be suspended or revoked if any false information is supplied toward securing the permit / any unauthorized changes are made to the site / any unauthorized changes are made in the installation of the system.

☐ ***IMPROVEMENT PERMIT*** *with plat valid without expiration.* ☐ ***IMPROVEMENT PERMIT*** *with plat valid without expiration.* Site plan valid 60 mo. ☐ ***AUTHORIZATION TO CONSTRUCT*** valid for period equal to IMPROVEMENT PERMIT--not to exceed 60 mo.

Owner / Applicant Signature: _____ Date _____ Installed by: _____

IMPROVEMENT PERMIT by: _____ ***REHS*** Date _____ OPERATION PERMIT by: _____ ***REHS*** Date _____

AUTHORIZATION TO CONSTRUCT by: _____ ***REHS*** Date _____ Existing System Inspected by: Steve Hedrick ***REHS*** Date 5/29/12

YOU SHOULD CONTACT A LOCATOR SERVICE PRIOR TO ANY EXCAVATION

White Copy – Environmental Health YELLOW COPY (Final) Owner / Applicant PINK COPY (Initial) Owner / Applicant