IREDELL COUNTY HEALTH DEPARTMENT

STATESVILLE 704-878-5305 MOORESVILLE 704-664-5281

IMPROVEMENT PERMIT / AUTHORIZATION TO CONSTRUCT / OPERATION PERMIT / EXISTING SYSTEM INSPECTION

PERMIT # 160435 PIN # 4775 11 8987 DATE April 15, 2010

OWNER or APPLICANT ~~Hans & Jane Heyman~~ Steve Malloy PHONE: Business Home: 816 726-5000

OWNER or APPLICANT ADDRESS P.O. Box 894, Catawba, NC 28609

LOCATION / DIRECTIONS Hwy 64 East TR New Salem Rd. TL Breckenridge on Right @ corner with R Stonehenge

SUBDIVISION Eastwood Acres BLOCK / SECTION LOT # 10+11 combined LOT AREA Approx. 7 Ac DESIGN FLOW 480gpd L.T.A.R. .25

Septic Tank 1000 Gallons: STB 760 Date 2-1-13

Pump Tank Gallons: P T Date

Pump Make Model Serial #

Nitrification Field No Fields 1 No Lines 4 Linear Feet 480

Trench Width 36" Trench Bottom Depth 36" Gravel Depth NA

☒ New System ☐ Repair ☐ Expansion System Type I II III IV V VI

System Description: GRAVITY Accepted (25% Reduction)

Repair System Description: GRAVITY Accepted (25% Reduction)

Maintenance Agreement Required ☐ YES ☒ NO

☒ GRAVITY ☐ PRESSURE

☒ Residence No. Bedrooms 4

☐ Business No. Persons

☐ Other No. Employees

☐ Slab ☒ Crawl Space

☐ Basement w/plumbing ☐ Basement w/o plumbing


Water Supply: ☐ Private ☒ Public ☐ Community

Comments / Conditions: Installer Note! Drainfield trenches to be installed at 36" trench bottom depth.


Nitrification Lines may need to be reflagged after site is cleaned.

Comments / Conditions: Apr 12, 2013 - OK to do left side entry garage

INITIAL SITE SKETCH

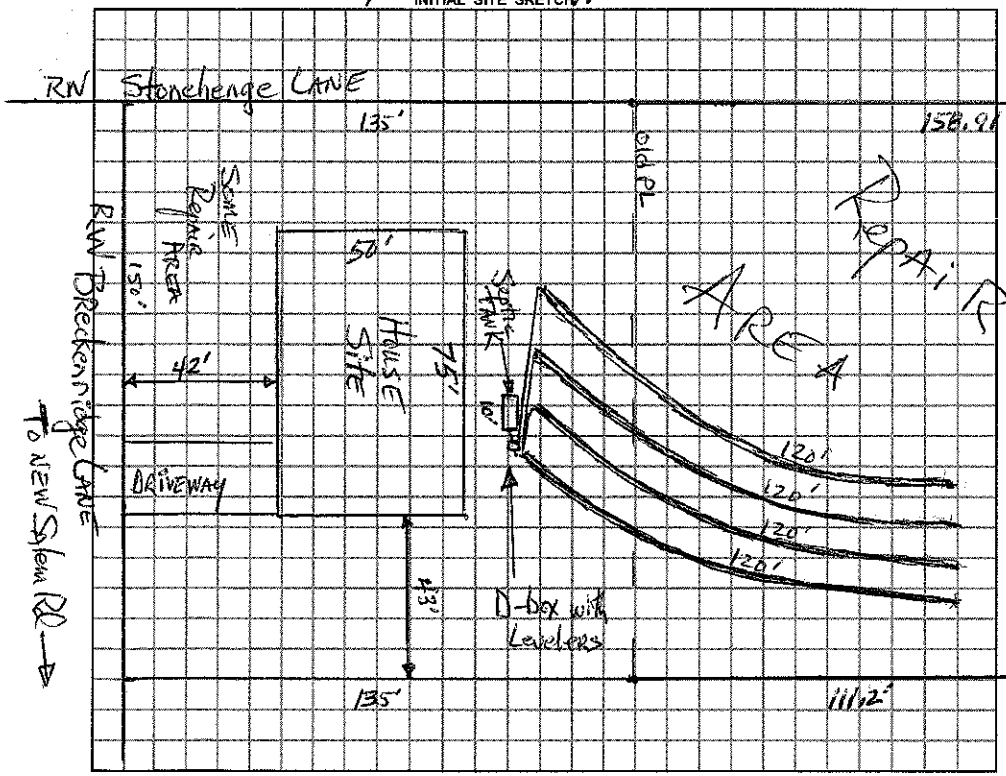

AS BUILT SKETCH

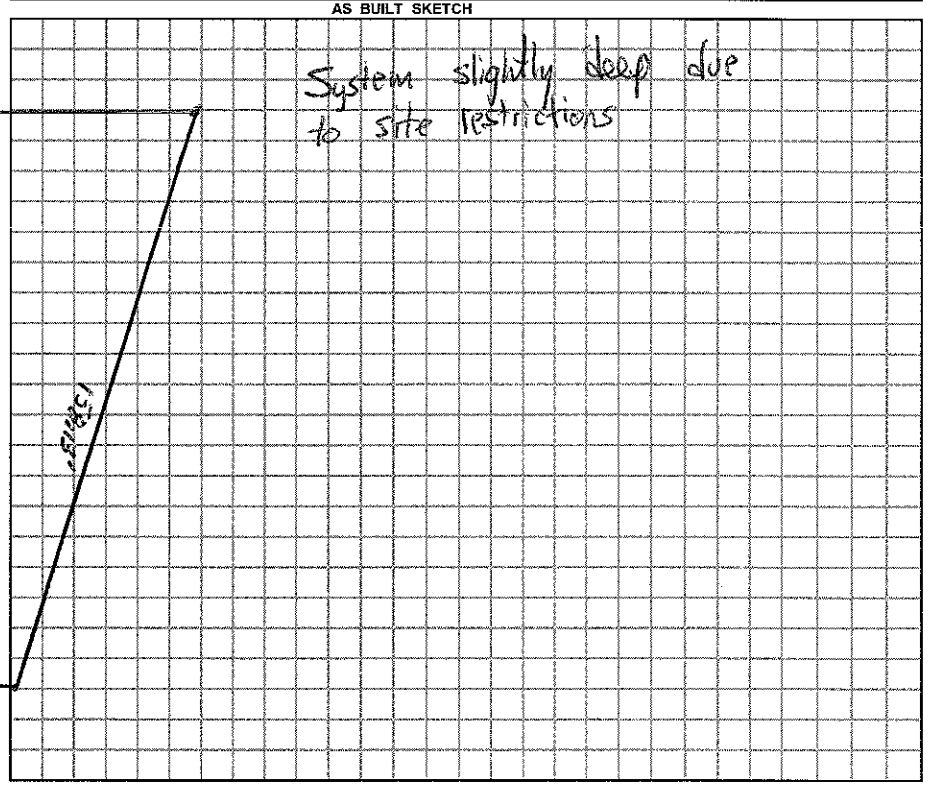

Permit can be suspended or revoked if any false information is supplied toward securing the permit / any unauthorized changes are made to the site / any unauthorized changes are made in the installation of the system.

☐ *IMPROVEMENT PERMIT w / plat valid without expiration.* ☒ *IMPROVEMENT PERMIT w / site plan valid for 60 mos.* ☐ *AUTHORIZATION TO CONSTRUCT valid for period equal to IMPROVEMENT PERMIT-not to exceed 60 mo.*

Owner / Applicant Signature: Steve Malloy Date 4-15-10

Improvement Permit by: D. K. Heyman, REHS Date 4-15-10

Authorization to Construct by: D. K. Heyman, REHS Date 4-12-13

YOU SHOULD CONTACT A LOCATOR SERVICE PRIOR TO ANY EXCAVATION.

Installed by: Gunter Construction

Operation Permit by: Date: 5-31-13

Existing System Inspected by: Date:

WHITE COPY Environmental Health YELLOW COPY (Final) Owner / Applicant PINK COPY (Initial) Owner / Applicant