IREDELL COUNTY HEALTH DEPARTMENT

Statesville Phone TR 3-7271 Mooresville Phone No. 664-5281

PERMIT TO INSTALL SEPTIC TANK

Permit No. 241 Permit Date 3-28 1973

Owner Harvey Cranfill Bldr Address Statesville NC

Installed By Raymond Adams Address Hiddenite N.C.


Location of Property Hwy 64 E. T.R. on Salem Church Rd
Just Past Church. T.L. on New Strut
1st house on R. Lot # 12

| Tank | | Capacity | | Length of Lines | | Fixtures | |
|---|---|---|---|---|---|---|---|
| Block | ( ) | 1000 | ( ) | 225' | ( ) | No. of Baths | (2) |
| Precast | (✓) | 1250 | (✓) | 250' | ( ) | Dishwasher | (✓) |
| | | 1500 | ( ) | Other 255 | | Garbage Grdr. | (✓) |
| | | Other | | | | Other | |

NOTIFY HEALTH DEPARTMENT AT LEAST EIGHT HOURS BEFORE TANK IS TO BE INSPECTED.

Final Inspection 3-28 1973 Approved (✓) Disapproved ( )

Remarks Iredell Water Corp.

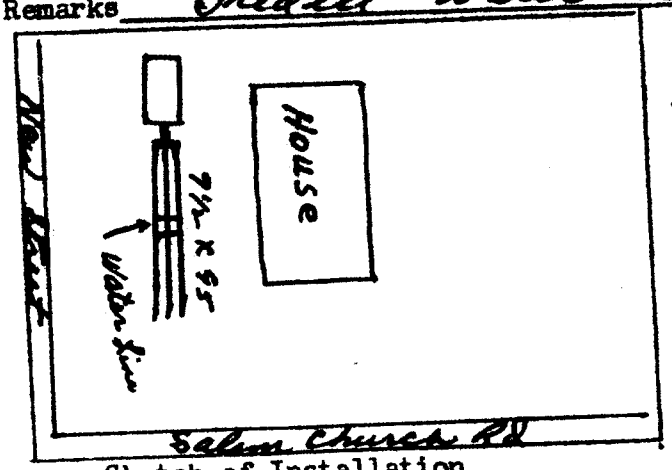

Sketch of Installation

10' solid line used when water line crosses system

E. A. Stevenson
Sanitarian