IREDELL COUNTY HEALTH DEPARTMENT

Statesville Phone TR 3-7271 Mooresville Phone No. 664-5281

PERMIT TO INSTALL SEPTIC TANK

Permit No. 41 Permit Date 6-19 1973

Owner Mr. WATT DEAL Address Rt. 4 STATESVILLE, NC

Installed By GILBERT BUSTLE Address Rt. 10 Box 301 Statesville


Location of Property HIGHWAY 64 E. TRAILER ON LEFT BEFORE NEW SALEM METH. CH. RD.

Tank		Capacity		Length of Lines		Fixtures	
Block	( )	1000	(✓)	225'	(✓)	No. of Baths	(TRAILER)
Precast	(✓)	1250	( )	250'	( )	Dishwasher	( )
		1500	( )	Other		Garbage Grdr.	( )
		Other				Other	

NOTIFY HEALTH DEPARTMENT AT LEAST EIGHT HOURS BEFORE TANK IS TO BE INSPECTED.

Final Inspection 6-19 1973 Approved (✓) Disapproved ( )

Remarks

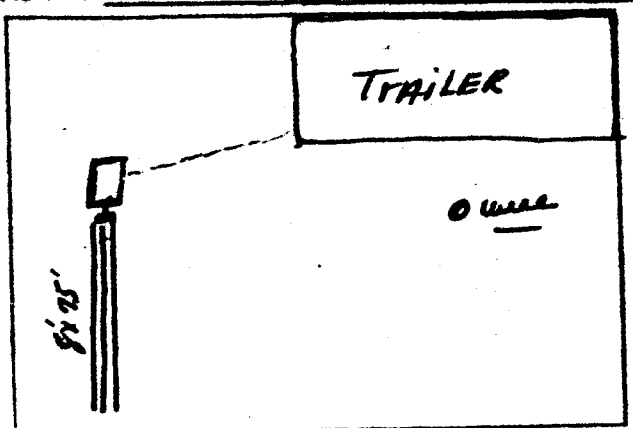

Sketch of Installation

Sanitarian