CI $130.00 TYPE III

IREDELL COUNTY HEALTH DEPARTMENT

STATESVILLE 704-878-5305 MOORESVILLE 704-664-5281

IMPROVEMENT PERMIT / AUTHORIZATION TO CONSTRUCT / OPERATION PERMIT / EXISTING SYSTEM INSPECTION

PERMIT# 107795 PIN# 4775-14-1190 DATE 07-19-02

OWNER OR CONTRACTOR SHELLY ROSENBALM PHONE Business _____ Home 704-924-6766

ADDRESS 1124 FOURTH CREEK LANDING STATESVILLE NC 28625

LOCATION 64E, (C) SAIN, (L) WINDING BROOKE, LOT # 111 ON LEFT

SUBDIVISION SPRING FOREST BLOCK / SECTION _____ LOT 14 LOT AREA .62 SITE CLASS PS DESIGN FLOW 360 L.T.A.R. .25

Septic Tank: 1600 Gallons: STB 1012 Date 3-9-02
Pump Tank: _____ Gallons: PT _____ Date _____
Pump Make: _____ Model _____ Serial No _____
Nitrification Field: No Fields 1 Square Feet 1440' Linear Feet 360'
No Lines 6X60' Trench Width 36" Max Trench Bottom Depth (24")

X New System ☐ Repair System Type: I, II (III) IV, V, VI
System Description: GRAY 2540 1200
Repair System Description: LP PANEL
Maintenance Agreement Required: ☐ Yes X No
Gravel Depth N/A ☐ Slab X Crawl Space ☐ Basement w/plumbing ☐ Basement wo/plumbing


X House/Mod Home No. Bedrooms 3
☐ Mobile Home No. Bathrooms 2
☐ Business No. Employees _____
☐ Other _____

Water Supply: ☐ Individual X Public ☐ Community


Comments/Conditions: (1) MAX. TRENCH BOTTOM DEPTH IS 24" (2) MAINTAIN SETBACKS & INSTALL ON CONTOURS (3) USE FLOW DIVIDER TEE

Comments/Conditions: [redacted] FRENCH DRAIN IS 44" DEEP & DRAIN LINE ARE 28-32" DEEP, DUE TO CONTOURS & SAVING TREE'S. SYSTEM INSTALLED B-4 HOUSE WAS BUILT.

INITIAL SITE SKETCH 1" = 50'

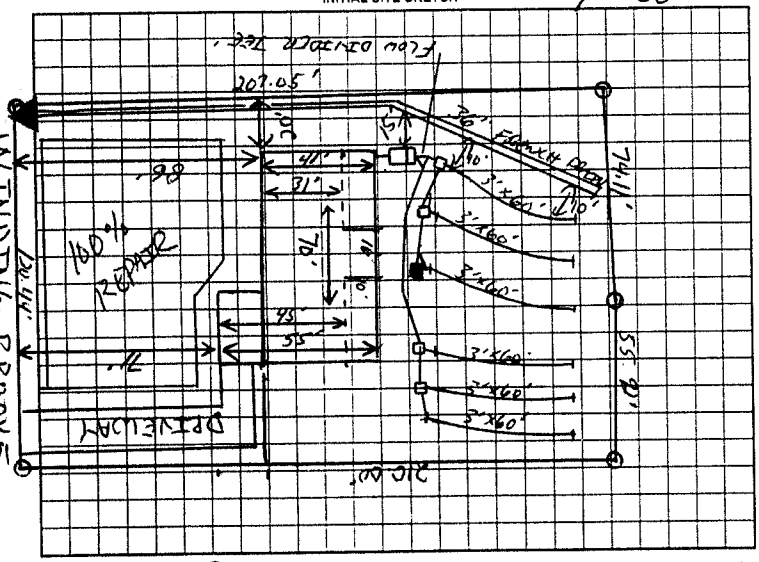

AS BUILT SKETCH

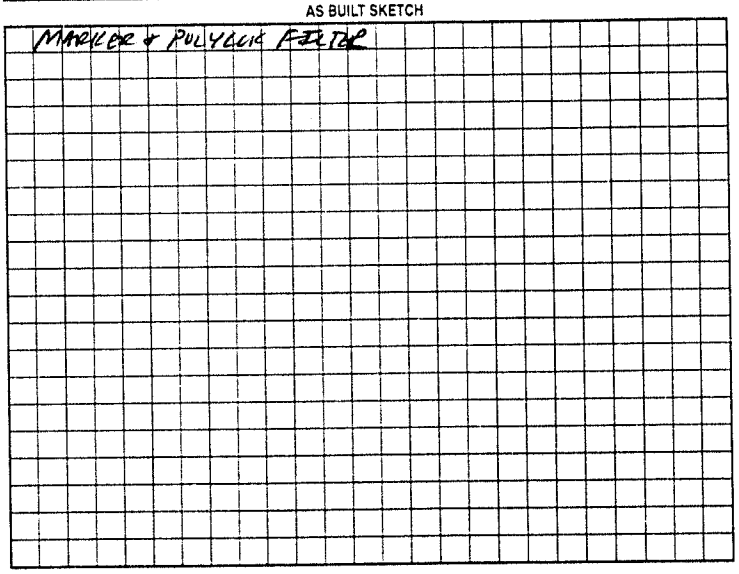

Permit can be suspended or revoked if any false information is supplied toward securing the permit/any unauthorized changes are made to the site/any unauthorized changes are made in the installation of the system. Improvement Permit with plat valid without expiration. Improvement Permit with site plan valid for sixty months. Authorization to Construct is valid for a period equal to that of Improvement Permit – not to exceed sixty months

Signed: X _____ date 7-19-02 Installed by A-1 BACKHOE

Improvement Permit by: _____ date 07-19-02 Operation Permit by: _____ date 07-22-02

Authorization to Construct by: _____ date 07-19-02 Existing System Inspection by: _____ date _____

HEALTH DEPT COPY: WHITE OWNER COPY (FINAL): YELLOW OWNER COPY (INITIAL): PINK