IREDELL COUNTY HEALTH DEPARTMENT

STATESVILLE 704-878-5305 MOORESVILLE 704-664-5281

IMPROVEMENT PERMIT / AUTHORIZATION TO CONSTRUCT / OPERATION PERMIT / EXISTING SYSTEM INSPECTION

PERMIT# 31532 PIN# 4775141460 DATE 10-17-05

OWNER OR CONTRACTOR Angel Dalton PHONE: Business 7048765416 Home

ADDRESS 721 Bailey Farm RD Statesville NC 28625

LOCATION 64E TL Stain TL Winding BROOK Property on Left

SUBDIVISION Spring Lake BLOCK / SECTION LOT 34/35 LOT AREA 1.14 AC SITE CLASS. B DESIGN FLOW 360 L.T.A.R. 125

Septic Tank: 1000 Gallons; STB #012 Date 2-14-07
Pump Tank: Gallons; PT Date
Pump Make: Model Serial No.
Nitrification Field: No Fields Square Feet 1440 Linear Feet 360
No Lines 5 Trench Width 36" Max Trench Bottom Depth 36" Gravel Depth

☑ New System ☐ Repair System Type: I II III IV V VI
System Description: 25% GRINDER Dep
Repair System Description: 50% Dep
Maintenance Agreement Required: ☐ Yes ☐ No

☑ House/Mod. Home No. Bedrooms 3
☐ Mobile Home No. Bathrooms
☐ Business No. Employees
☐ Other


☐ Slab ☐ Crawl Space ☑ Basement w/plumbing ☐ Basement wo/plumbing

Water Supply: ☐ Individual ☑ Public ☐ Community


Comments:/Conditions: Install on contour
Maintain all set backs
(1" = 60')

Comments:/Conditions: Call Health Dept for Re-layout before installation
Yellow Lateral

INITIAL SITE SKETCH

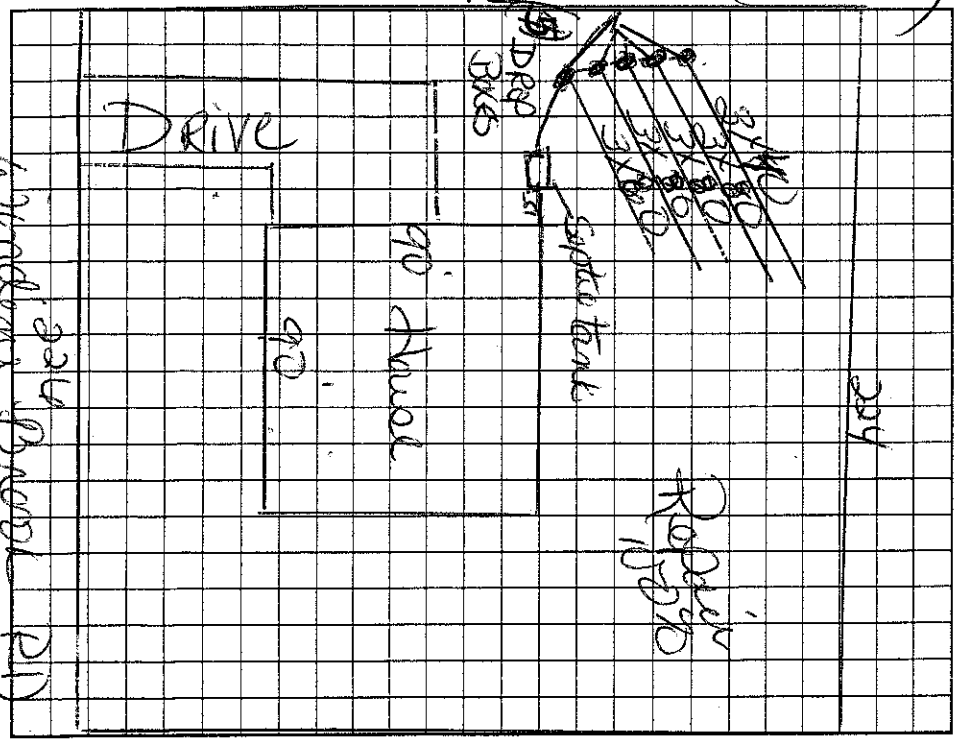

AS BUILT SKETCH

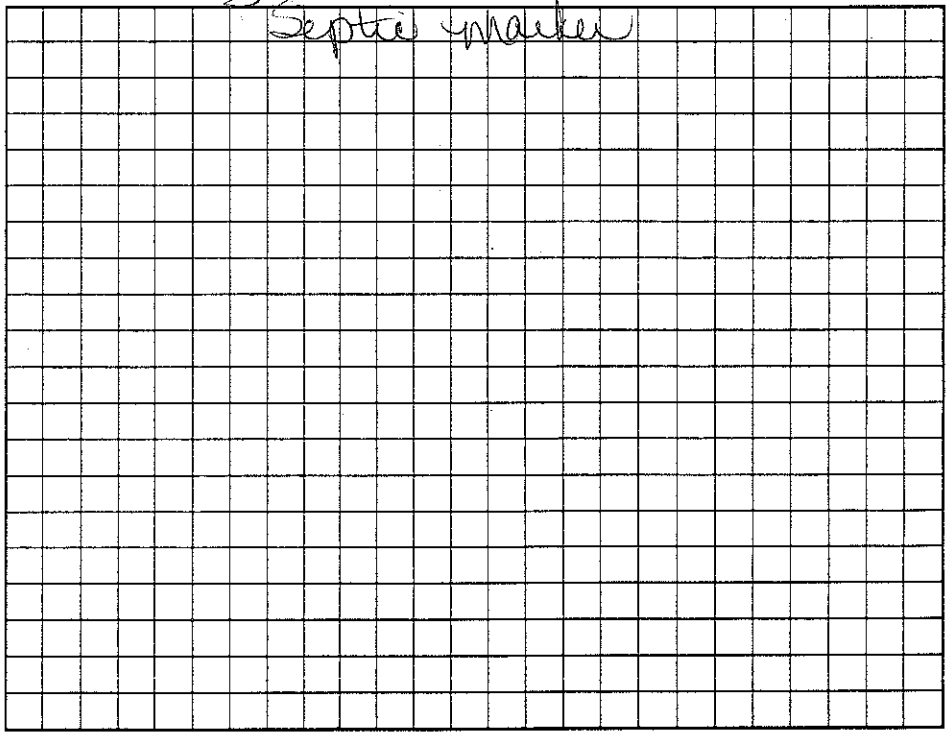

Permit can be suspended or revoked if any false information is supplied toward securing the permit/any unauthorized changes are made to the site/any unauthorized changes are made in the installation of the system. Improvement Permit with plat valid without expiration. Improvement Permit with site plan valid for sixty months. Authorization to Construct is valid for a period equal to that of Improvement Permit – not to exceed sixty months.

Signed: [signature] date 10-31-05 Installed by: D-J Backhoe

Improvement Permit by: Kenny Cook date 10-17-05 Operation Permit by: Kenny Cook date 8-1-07

Authorization to Construct by: Kenny Cook date 10-17-05 Existing System Inspection by: date

HEALTH DEPT. COPY: WHITE OWNER COPY (FINAL): YELLOW OWNER COPY (INITIAL): PINK