IREDELL COUNTY HEALTH DEPARTMENT

STATESVILLE 704-878-5305 CI MOORESVILLE 704-664-5281

IMPROVEMENT PERMIT / AUTHORIZATION TO CONSTRUCT / OPERATION PERMIT / EXISTING SYSTEM INSPECTION

PERMIT# 106926 PIN# 4775-14-1936 DATE 07-16-02

OWNER OR CONTRACTOR TERRA TEK INC PHONE: Business 704-902-0119 Home

ADDRESS 630 SIGNAL DRIVE EXT. STATESVILLE, NC 28625

LOCATION STATESVILLE-7 64E, (L) SAIN, (L) SPRING FOREST, (L) HOWARD POND, LOT ON RT # 64

SUBDIVISION SPRING FOREST BLOCK / SECTION LOT 64 LOT AREA 0.6523 SITE CLASS PS DESIGN FLOW 360 L.T.A.R. .3

Septic Tank: 1000 Gallons; STB 1017 Date 8-23-02
Pump Tank: 1000 Gallons; PT 17 Date 1-10-03
Pump Make: GOULDS Model VE 0512 H Serial No. 50417805/0337-9
Nitrification Field: No Fields 1 Square Feet ED=1200" Linear Feet 300"
No Lines 3X100" Trench Width 36" Max Trench Bottom Depth 36" Gravel Depth N/A

[X] New System [ ] Repair System Type: I, II, (III) IV, V, VI
System Description: PUMP 25% 1200
Repair System Description: LP PANEL
Maintenance Agreement Required: [ ] Yes [X] No


[X] House/Mod. Home No. Bedrooms 3
[ ] Mobile Home No. Bathrooms 2.5
[ ] Business No. Employees
[ ] Other
[ ] Slab [X] Crawl Space [ ] Basement w/plumbing [ ] Basement wo/plumbing

Water Supply: [ ] Individual [X] Public [ ] Community


Comments:/Conditions: (1) INSTALL LINES ON CONTOUR (2) CALL PRIOR TO INSTALLATION FOR PUMP SIZING SPEC'S, (3) MAINTAIN SETBACKS, (4) SYSTEM & HOUSE IS FLAGGED OUT COMPLETELY.

Comments:/Conditions: TUFF TITE FILTER & MARKER APPROVED TANKS TO BE MOVED TO SIDE OF HOUSE, LL 4/28/03 V'D LINES & TANKS ON 4-23-03/ V'D ELEVATION & PRESSURE, EVERYTHING V'D OK, LL 4-24-03

INITIAL SITE SKETCH 1"=50'

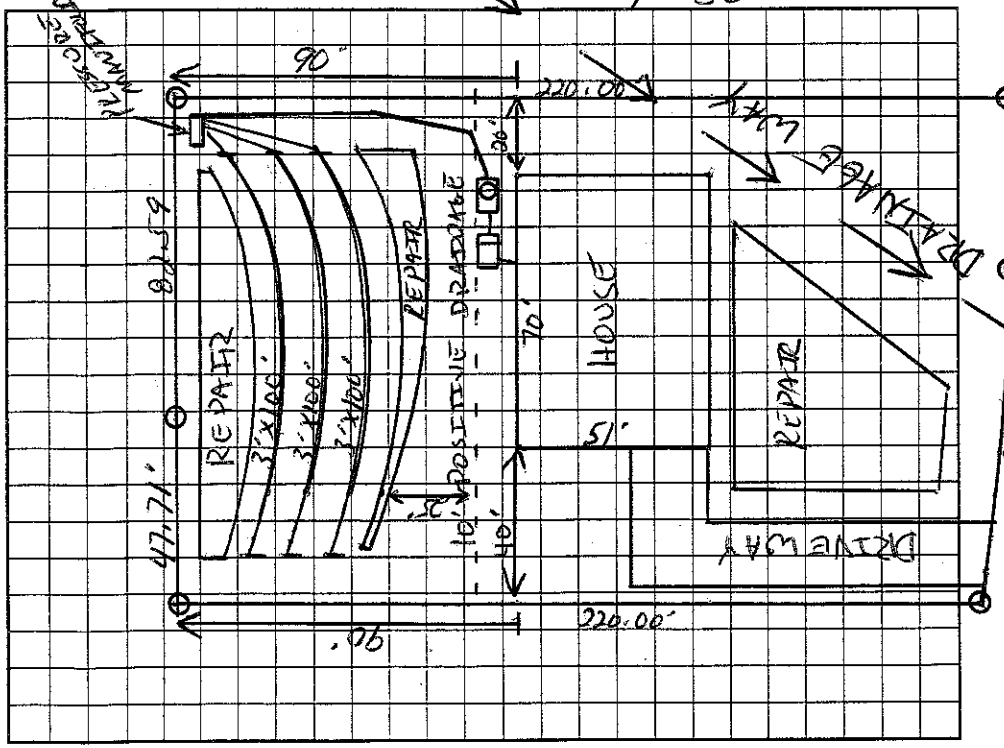

AS BUILT SKETCH

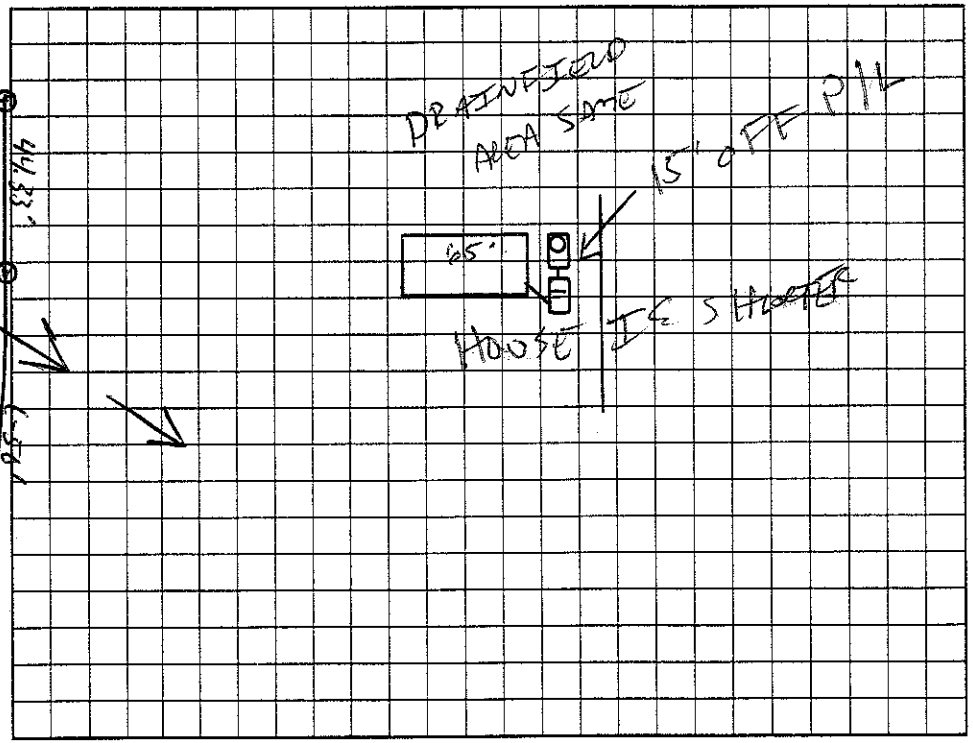

Permit can be suspended or revoked if any false information is supplied toward securing the permit/any unauthorized changes are made to the site/any unauthorized changes are made in the installation of the system. Improvement Permit with plat valid without expiration. Improvement Permit with site plan valid for sixty months. Authorization to Construct is valid for a period equal to that of Improvement Permit – not to exceed sixty months.

Signed: date 7-25-02 Installed by: DAVID YOUNTZ

Improvement Permit by: RS date 07/16/02 Operation Permit by: RS date 4-24-03

Authorization to Construct by: RS date 07-16-02 Existing System Inspection by: date

HEALTH DEPT. COPY: WHITE OWNER COPY (FINAL): YELLOW OWNER COPY (INITIAL): PINK