206002 New Permit # 206022

IREDELL COUNTY HEALTH DEPARTMENT

STATESVILLE 704-878-5305 MOORESVILLE 704-664-5281

IMPROVEMENT PERMIT / AUTHORIZATION TO CONSTRUCT / OPERATION PERMIT / EXISTING SYSTEM INSPECTION

PERMIT# 29622 PIN# ~~4775-14-1132~~ 4775-14-3132 DATE 5-23-08

OWNER OR APPLICANT Paul Dellinger PHONE: Business _____ Home 913 782 9196

ADDRESS 1809 Stafford Rd Olathe KS 66062

LOCATION 64E to 3rd to Windsong Blvd 4th on left

SUBDIVISION Spring Forest BLOCK / SECTION _____ LOT 43 LOT AREA 1.743 SITE CLASS. B DESIGN FLOW 360 L.T.A.R. 3

Septic Tank: 1000 Gallons; STB 1012-1000 Date 8-16-14

Pump Tank: 1000 Gallons; PT 17-1000 Date 8-8-14

Pump Make: Gould's Model 1/3 Serial No. WE0312M4

Nitrification Field: No Fields ___ Square Feet 1200 Linear Feet 300

No Lines 3 Trench Width 36" Max Trench Bottom Depth 32 Gravel Depth _____

☑ New System ☐ Repair ☐ Expansion System Type: I II III IV V VI

System Description: 2370 Pump

Repair System Description: 50% Leach Field

Maintenance Agreement Required: ☐ Yes ☐ No

☑ House/Mod. Home No. Bedrooms 3

☐ Mobile Home No. Persons ___

☐ Business No. Employees ___

☐ Other _____

Water Supply: ☑ Individual ☐ Public ☐ Community

☐ Gravity ☐ Pressure ☐ Slab ☑ Crawl Space ☐ Basement w/plumbing ☐ Basement wo/plumbing


Comments:/Conditions:

Install on Contour
Maintain all setback


Comments:/Conditions:

Backfill for Positive Drainage

INITIAL SITE SKETCH

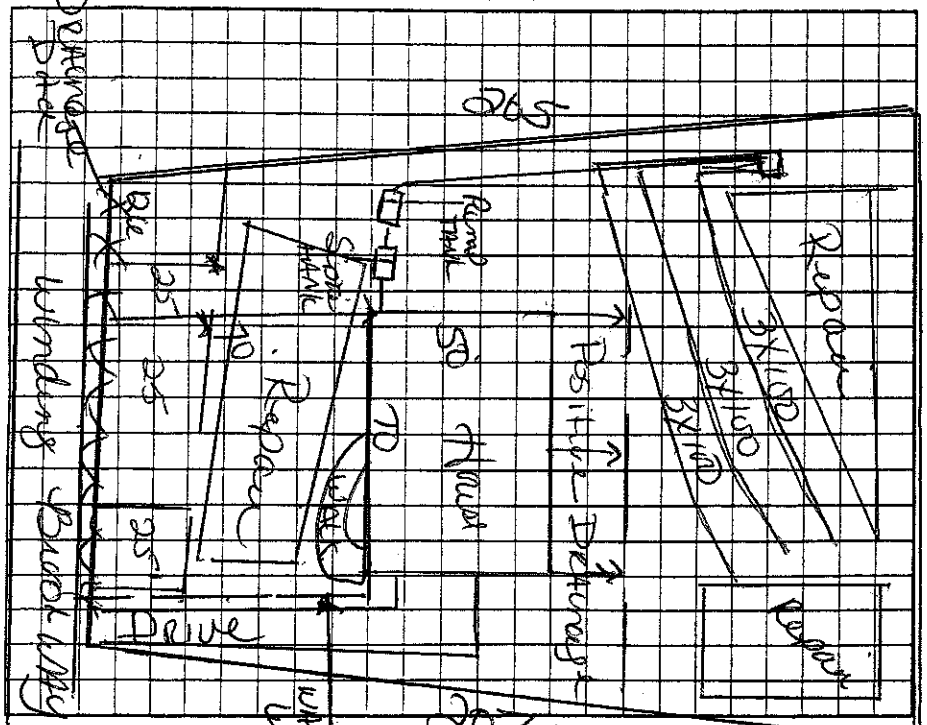

AS BUILT SKETCH

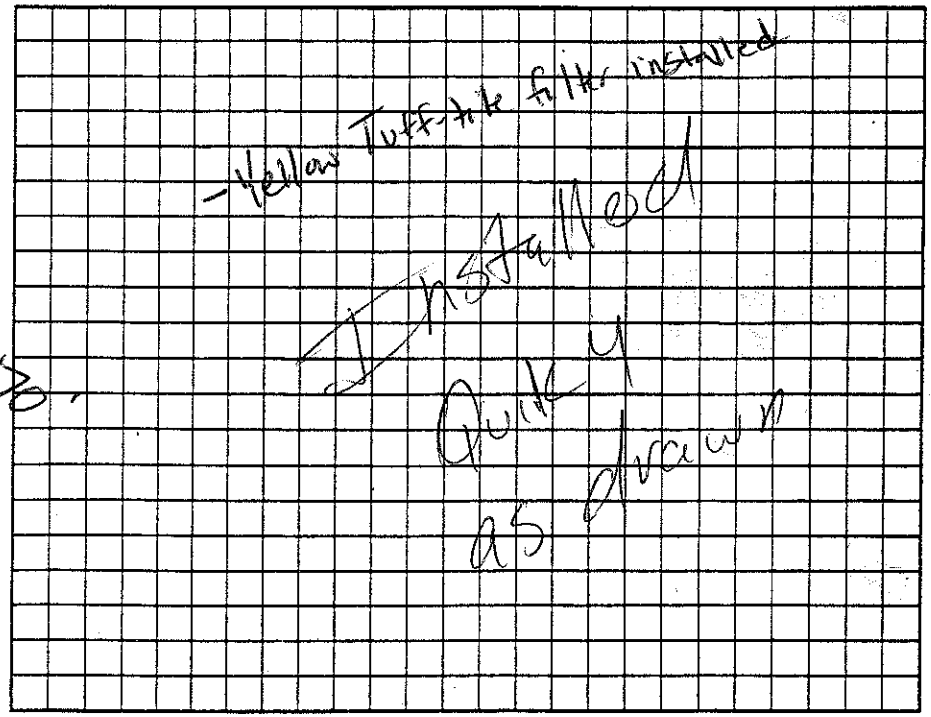

Permit can be suspended or revoked if any false information is supplied toward securing the permit/any unauthorized changes are made to the site/any unauthorized changes are made in the installation of the system. Improvement Permit with plat valid without expiration ☐ Improvement Permit with site plan valid for sixty months ☑ Authorization to Construct is valid for a period equal to that of Improvement Permit – not to exceed sixty months.

Signed: _____ date 5-23-08 Installed by: Yountz Septic

Improvement Permit by: _____ date 5-23-08 Operation Permit by: _____ date 02/06/15

Authorization to Construct by: _____ date 09/24/14 Existing System Inspection by: _____ date _____

HEALTH DEPT. COPY: WHITE OWNER COPY (FINAL): YELLOW OWNER COPY (INITIAL): PINK

	Date	Initials
Drain Lines Checked	HS	2-6-15
Tanks Checked	JH	1-30-15
Pressure Manifold or Valve Box Checked	HS	2-6-15
Pressure Head Set	HS	2-6-15
Electrical Checked	HS	2-6-15
Floats Set	HS	2-6-15
Alarm Checked	HS	2-6-15
Maintenance Contract Y / N	N/A	

IREDELL COUNTY HEALTH DEPARTMENT

STATESVILLE 704-878-5305 MOORESVILLE 704-664-5281

IMPROVEMENT PERMIT / AUTHORIZATION TO CONSTRUCT / OPERATION PERMIT / EXISTING SYSTEM INSPECTION

PERMIT# 12962220 PIN# 4775141321 DATE 6-30-05

OWNER OR CONTRACTOR Tungsten INC PHONE: Business 704-902-0119 Home 704-902-0119

ADDRESS 630 Signal Hill Dr

LOCATION 64 to Sloan Rd TL Winding brook Way

SUBDIVISION Spring Forest BLOCK / SECTION ____ LOT 13 LOT AREA 1.143 SITE CLASS. B DESIGN FLOW 360 L.T.A.R. 3

Septic Tank: 1000 Gallons; STB ____ Date ____

Pump Tank: ____ Gallons; PT ____ Date ____

Pump Make: ____ Model ____ Serial No. ____

Nitrification Field: No Fields 1 Square Feet 1200 Linear Feet 300

No Lines 3 Trench Width 36" Max Trench Bottom Depth 36" Gravel Depth ____

☐ New System ☐ Repair System Type: I, II, III, IV, V, VI

System Description: Pump-25% red - gravel

Repair System Description: 50% Pump 1000 gal

Maintenance Agreement Required: ☐ Yes ☑ No

☐ House/Mod. Home No. Bedrooms 3

☐ Mobile Home No. Bathrooms ____

☐ Business No. Employees ____

☐ Other ____

☐ Slab ☑ Crawl Space ☐ Basement w/plumbing ☐ Basement wo/plumbing

Water Supply: ☐ Individual ☑ Public ☐ Community

Comments:/Conditions: 36" Trench Depth


See attached Pressure manifold & Pump

Repair Pump to low pressure 1"=50'

Comments:/Conditions:

Requirements

INITIAL SITE SKETCH

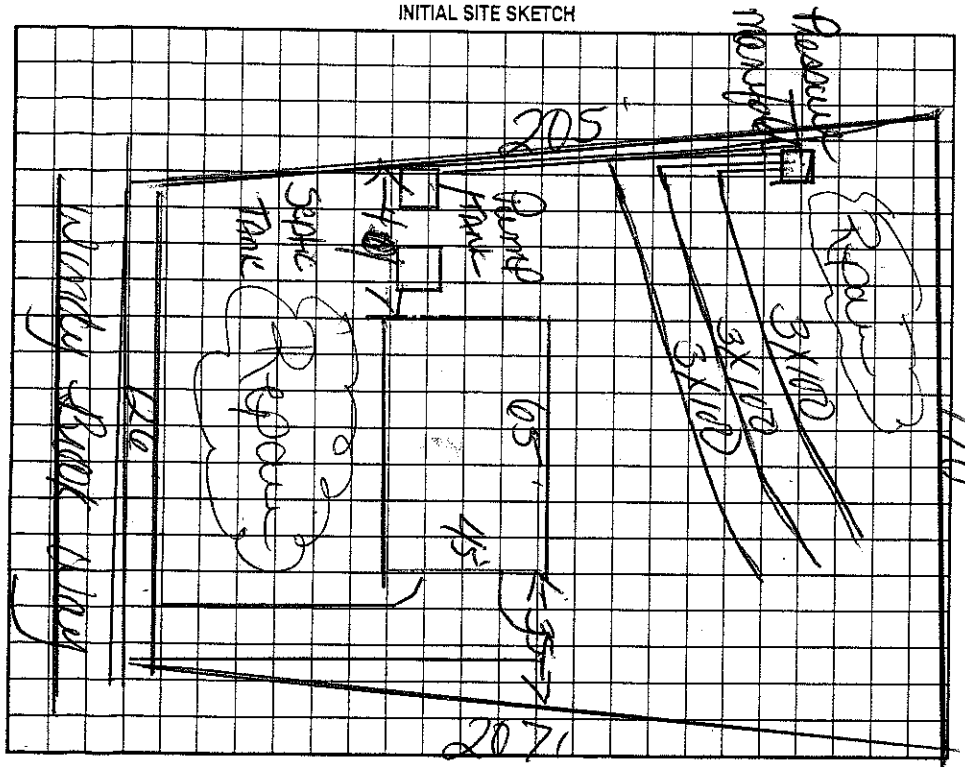

AS BUILT SKETCH

Permit can be suspended or revoked if any false information is supplied toward securing the permit/any unauthorized changes are made to the site/any unauthorized changes are made in the installation of the system. Improvement Permit with plat valid without expiration. Improvement Permit with site plan valid for sixty months. Authorization to Construct is valid for a period equal to that of Improvement Permit – not to exceed sixty months.

Signed: [signature] date 8-30-05 Installed by: ____

Improvement Permit by: Keri Cook date 6-30-05 Operation Permit by: ____ date ____

Authorization to Construct by: ____ date ____ Existing System Inspection by: ____ date ____

HEALTH DEPT. COPY: WHITE OWNER COPY (FINAL): YELLOW OWNER COPY (INITIAL): PINK