CI | CI

IREDELL COUNTY HEALTH DEPARTMENT

STATESVILLE 704-878-5305 MOORESVILLE 704-664-5281

IMPROVEMENT PERMIT / AUTHORIZATION TO CONSTRUCT / OPERATION PERMIT / EXISTING SYSTEM INSPECTION

PERMIT# 106925 PIN# 4775-14-5422 DATE 08-14-02

OWNER OR CONTRACTOR TERRATEK PHONE: Business 704-902-0119 Home

ADDRESS 630 SIGNAL DRIVE EXT STATESVILLE, NC 28625

LOCATION 64 EAST, ① SAIN, ② WINDING BROOKE, 60 [illegible] LOT # 37

SUBDIVISION SPRING FOREST BLOCK / SECTION LOT 37 LOT AREA .6263 SITE CLASS. RIGHT PS DESIGN FLOW 360 L.T.A.R. 13

Septic Tank: 1000 Gallons; STB 1012 Date 6-10-02
Pump Tank: Gallons; PT Date
Pump Make: Model Serial No.
Nitrification Field: No Fields 1 Square Feet 1200' Linear Feet 400'
No Lines 4 Trench Width 36" Max Trench Bottom Depth 36" Gravel Depth 12"

☒ New System ☐ Repair System Type: I, II, III, IV, V, VI
System Description: CONV GRAV
Repair System Description: LP PANEL
Maintenance Agreement Required: ☐ Yes ☒ No

☒ House/Mod. Home ☐ Mobile Home ☐ Business ☐ Other
No. Bedrooms 3 No. Bathrooms 2.5 No. Employees


☐ Slab ☒ Crawl Space ☐ Basement w/plumbing ☐ Basement wo/plumbing

Water Supply: ☐ Individual ☒ Public ☐ Community


Comments/Conditions: ① TOILET CAN BE PUT IN GARAGE IF WANTED DO NOT ADD BEDROOM IN GARAGE OR PERMIT WILL BE VOIDED BECAUSE OF DESIGN FLOW CHANGE. ② SYSTEM IS ENTIRELY FLAGGED OUT EVERY 10'. ③ MAINTAIN

Comments/Conditions: SEPTAPULS TUFFTITE FILTER

INITIAL SITE SKETCH 1" = 50'

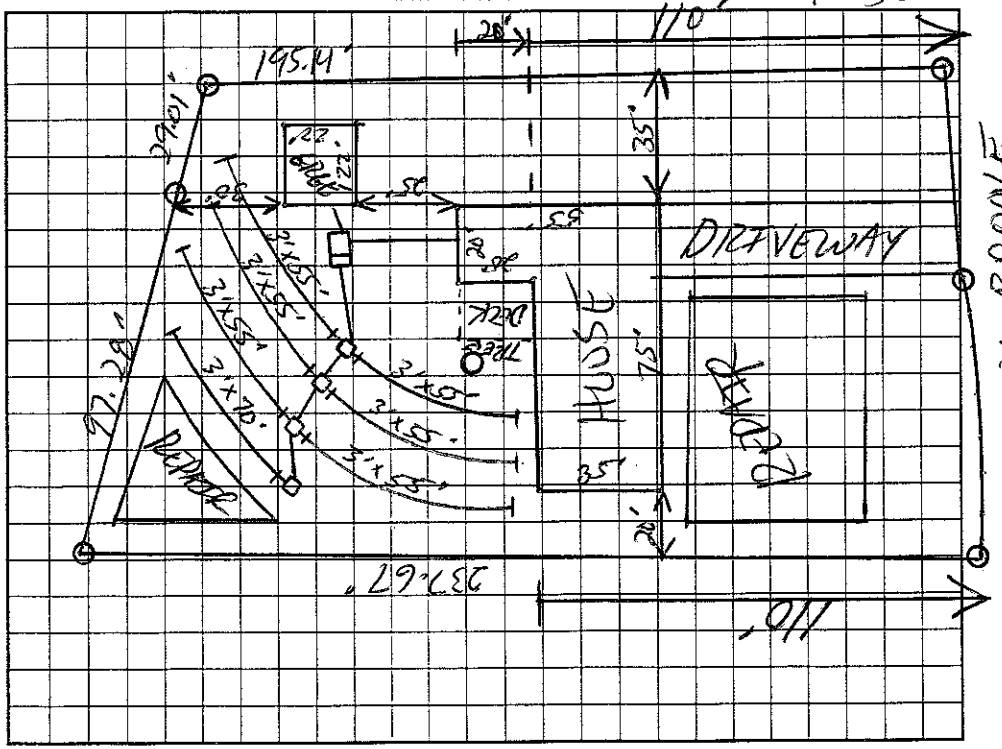

AS BUILT SKETCH

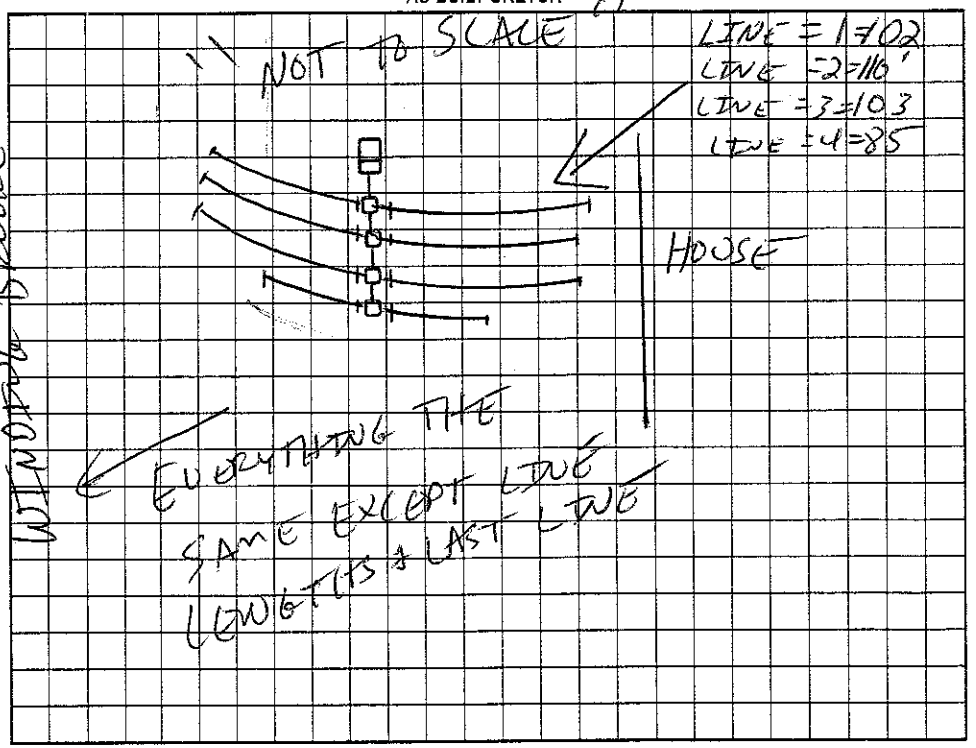

Permit can be suspended or revoked if any false information is supplied toward securing the permit/any unauthorized changes are made to the site/any unauthorized changes are made in the installation of the system. Improvement Permit with plat valid without expiration. Improvement Permit with site plan valid for sixty months. Authorization to Construct is valid for a period equal to that of Improvement Permit – not to exceed sixty months.

Signed: date 8-21-02 Installed by: DAVID YOUNTZ

Improvement Permit by: date 8-14-02 Operation Permit by: date 01-15-03

Authorization to Construct by: RS date 8-14-02 Existing System Inspection by: date

HEALTH DEPT. COPY: WHITE OWNER COPY (FINAL): YELLOW OWNER COPY (INITIAL): PINK