IREDELL COUNTY HEALTH DEPARTMENT

STATESVILLE 704-878-5305 MOORESVILLE 704-664-5281

IMPROVEMENT PERMIT / AUTHORIZATION TO CONSTRUCT / OPERATION PERMIT / EXISTING SYSTEM INSPECTION

PERMIT# 141966 PIN# 4775147046.002 6142 DATE 7-12-07

OWNER OR APPLICANT Stiles, Ellis & Pope Build Co. PHONE: Business 704-873-7373 Home

ADDRESS 611 B Sullivan RD Statesville NC 28625

LOCATION 64E (L) Spring RD (L) Winding Brook 2nd lot on left

SUBDIVISION Spring Forest BLOCK / SECTION LOT 8 LOT AREA SITE CLASS. PS DESIGN FLOW 360 L.T.A.R. .25 / .2

Septic Tank: 1000 Gallons; STB 1012 Date 5-28-07
Pump Tank: 1000 Gallons; PT 17 Date 9-19-07
Pump Make: Model Serial No.
Nitrification Field: No Fields Square Feet 1440 Linear Feet 360
No Lines 4 Trench Width 36" Max Trench Bottom Depth 36" Gravel Depth NA ☐ Gravity ☑ Pressure

☑ New System ☐ Repair ☐ Expansion System Type: I II III IV V VI
System Description: 25% Pump Pr
Repair System Description: 50% Pump Pr
Maintenance Agreement Required: ☐ Yes ☑ No

☑ House/Mod. Home ☐ Mobile Home ☐ Business ☐ Other
No. Bedrooms 3 No. Persons No. Employees


Water Supply: ☐ Individual ☑ Public ☐ Community

☐ Slab ☑ Crawl Space ☐ Basement w/plumbing ☐ Basement wo/plumbing


Comments:/Conditions: No sprinkler system over repair or initial system

Comments:/Conditions: Install as Custom. Maintain all setbacks

INITIAL SITE SKETCH

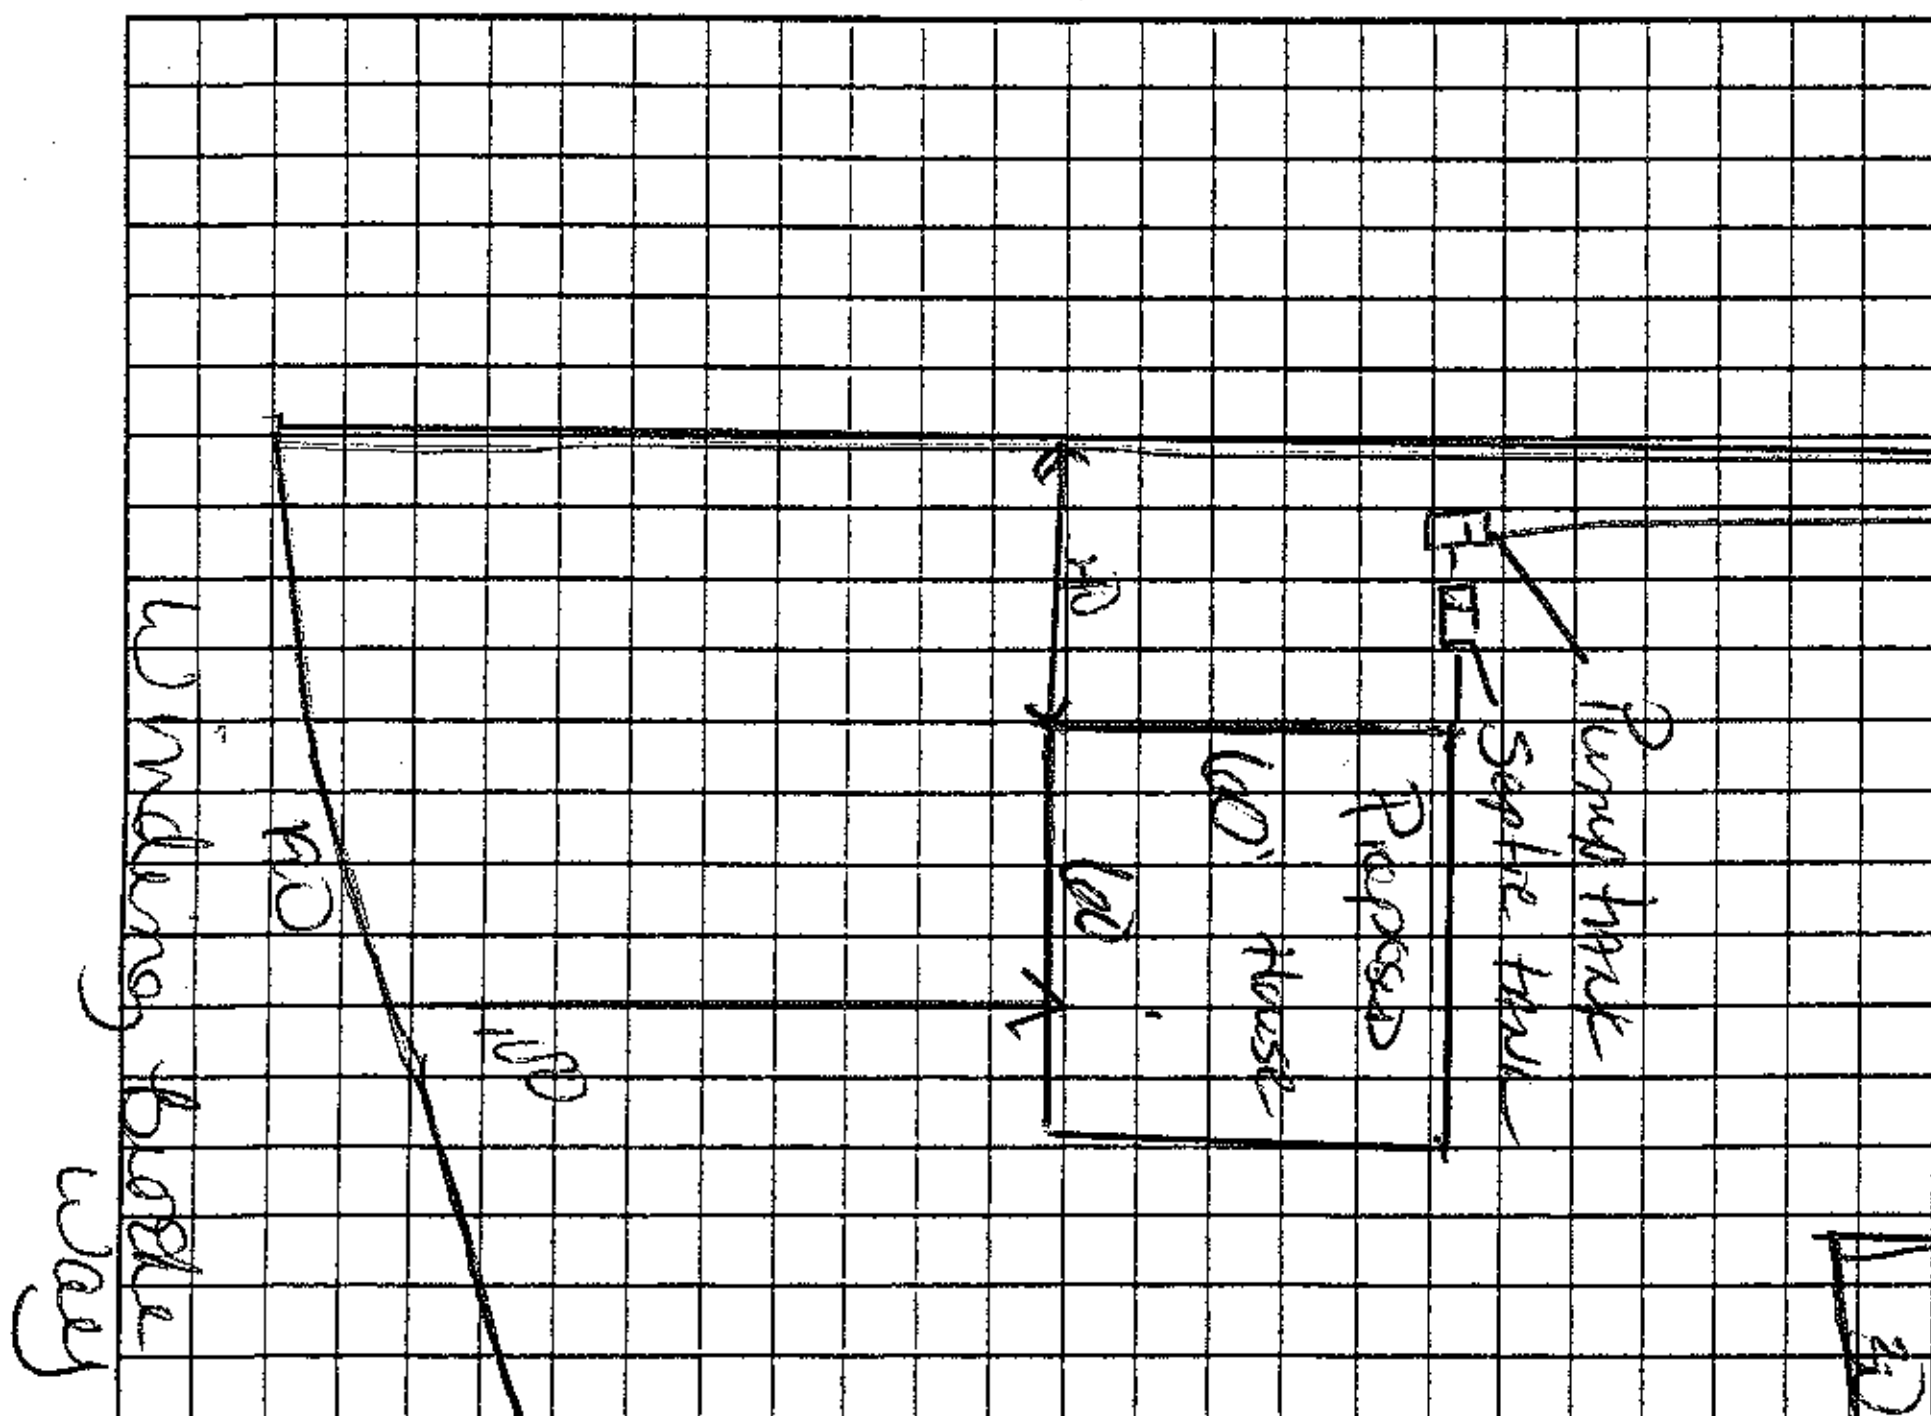

AS BUILT SKETCH

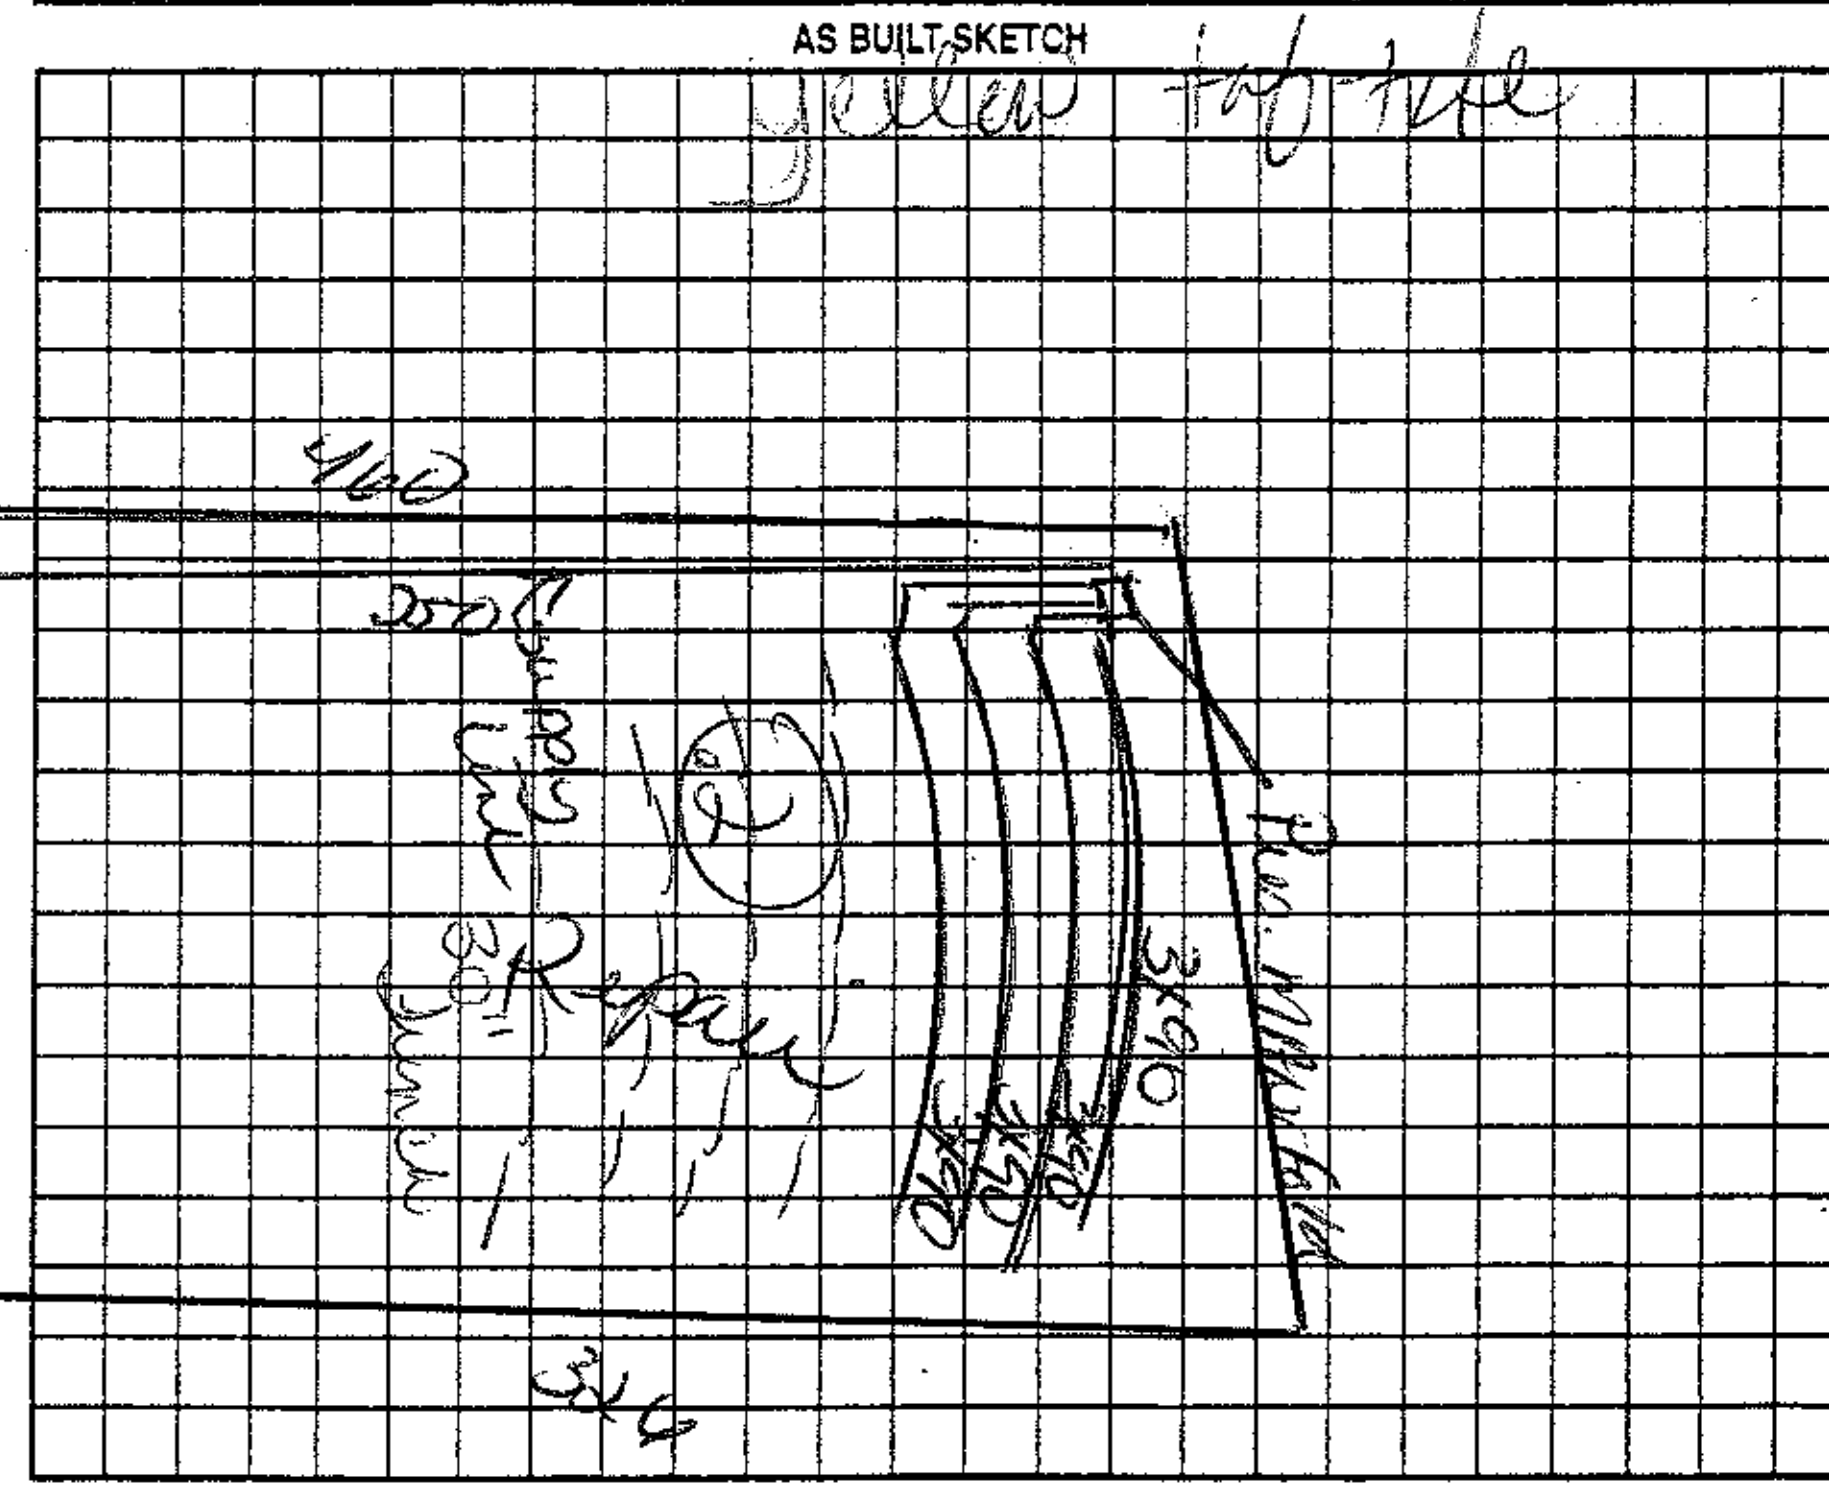

Permit can be suspended or revoked if any false information is supplied toward securing the permit/any unauthorized changes are made to the site/any unauthorized changes are made in the installation of the system. Improvement Permit with plat valid without expiration ☐ Improvement Permit with site plan valid for sixty months ☐ Authorization to Construct is valid for a period equal to that of Improvement Permit – not to exceed sixty months.

Signed: Dale Sloan date

Improvement Permit by: Kevin Carr date 7-12-07

Authorization to Construct by: Kevin Carr date 7-12-07

Installed by: David Yountz

Operation Permit by: Kevin Carr date 2-25-08

Existing System Inspection by: date

HEALTH DEPT. COPY: WHITE OWNER COPY (FINAL): YELLOW OWNER COPY (INITIAL): PINK