IREDELL COUNTY HEALTH DEPARTMENT

STATESVILLE 704-878-5305 MOORESVILLE 704-664-5281

IMPROVEMENT PERMIT / AUTHORIZATION TO CONSTRUCT / OPERATION PERMIT / EXISTING SYSTEM INSPECTION

PERMIT# 13149 PIN# 4775147584 DATE 10-5-05

OWNER OR CONTRACTOR Sweatt, Inc PHONE: Business 704-878-6633 Home

ADDRESS 630 Signal Hill Drive Elk

LOCATION GTE Rd Spainhour Rd (Spring Trail) Rt Windy Brook Way 2nd lot on Right

SUBDIVISION Spring Trail BLOCK / SECTION LOT 39 LOT AREA 1.28 SITE CLASS RS DESIGN FLOW 360 L.T.A.R. .25

Septic Tank: 1000 Gallons; STB 312 Date 8-22-05

Pump Tank: Gallons; PT Date

Pump Make: Model Serial No.

Nitrification Field: No. Fields Square Feet 1470 Linear Feet 380

No. Lines 5 Trench Width 36" Max Trench Bottom Depth 36" Gravel Depth N/A

☐ New System ☐ Repair System Type: I II III IV V VI

System Description: 25% Red-Ciconia

Repair System Description: LPP

Maintenance Agreement Required: ☐ Yes ☐ No

☐ House/Mod. Home No. Bedrooms 3

☐ Mobile Home No. Bathrooms

☐ Business No. Employees

☐ Other

☐ Slab ☐ Crawl Space ☐ Basement w/plumbing ☐ Basement wo/plumbing


Water Supply: ☐ Individual ☐ Public ☐ Community

Comments/Conditions: Installer Master maintain all setbacks


Comments/Conditions: Septic Keep & Maint Red Polytex Filter

* 36" Trench Bottom

INITIAL SITE SKETCH

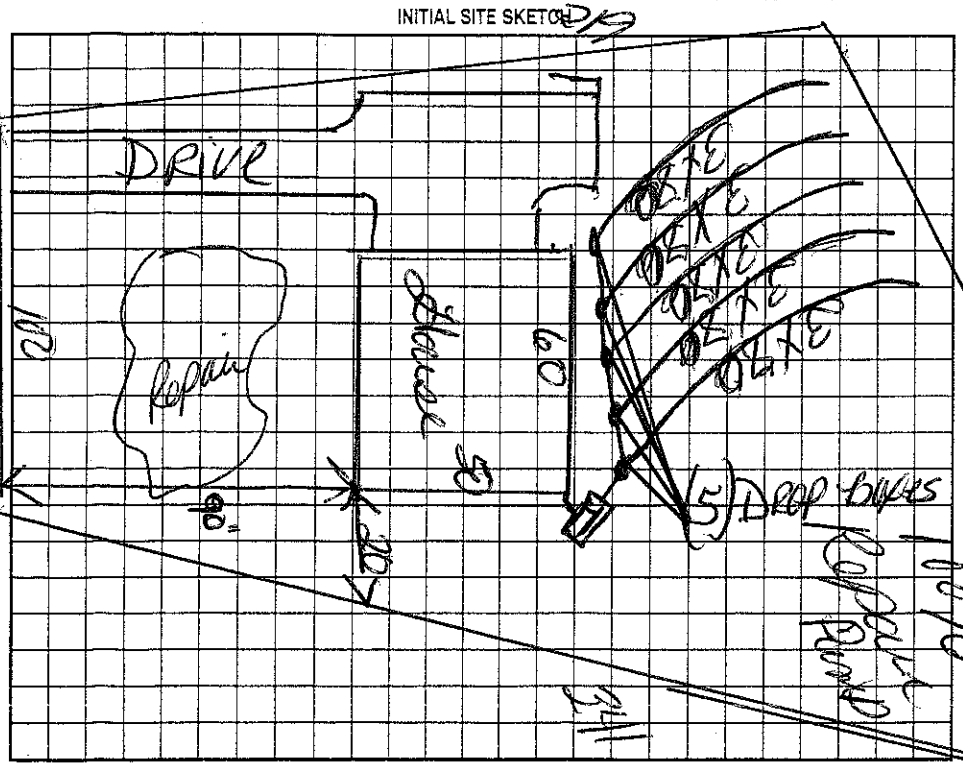

AS BUILT SKETCH

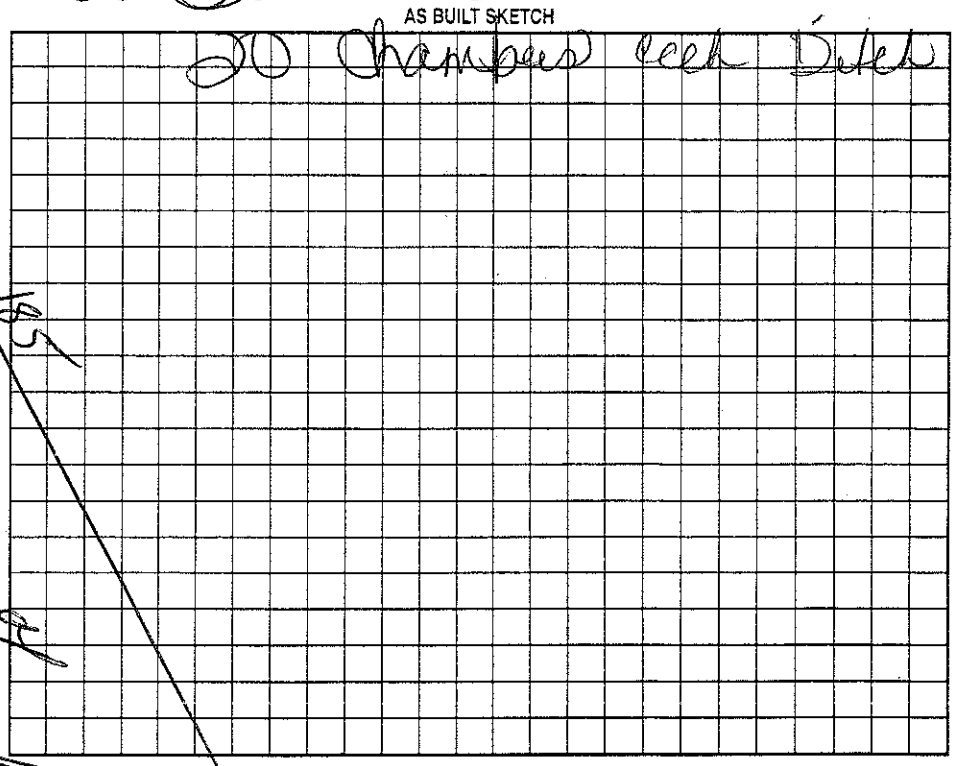

Permit can be suspended or revoked if any false information is supplied toward securing the permit/any unauthorized changes are made to the site/any unauthorized changes are made in the installation of the system. Improvement Permit with plat valid without expiration. Improvement Permit with site plan valid for sixty months. Authorization to Construct is valid for a period equal to that of Improvement Permit – not to exceed sixty months.

Signed: date 10-24-05 Installed by: Wes Clifton Cook

Improvement Permit by: date 10-5-05 Operation Permit by: date 10-4-06

Authorization to Construct by: date 11-6-06 Existing System Inspection by: date

HEALTH DEPT. COPY: WHITE OWNER COPY (FINAL): YELLOW OWNER COPY (INITIAL): PINK