2:30

IREDELL COUNTY HEALTH DEPARTMENT

STATESVILLE 704-878-5305 MOORESVILLE 704-664-5281

IMPROVEMENT PERMIT / AUTHORIZATION TO CONSTRUCT / OPERATION PERMIT / EXISTING SYSTEM INSPECTION

PERMIT# 14196-2 PIN# 4775-14-7066.000 8143 DATE 7-13-07

OWNER OR APPLICANT Stiles Ellis, Pope Building PHONE: Business 704-873-7353 Home

ADDRESS 611 B Sullivan RD Statesville 28625

LOCATION 64 East to Salisbury RD 1st left on left down Winding Brook

SUBDIVISION Spring Forest BLOCK / SECTION LOT #1 LOT AREA 2.64 SITE CLASS. P5 DESIGN FLOW 480 L.T.A.R. .2

Septic Tank: 1000 Gallons; STB 1012 Date 5/22/07
Pump Tank: 1000 Gallons; PT 17-1000 Date 12/15/07
Pump Make: Model Serial No.
Nitrification Field: No Fields Square Feet 2000 Linear Feet 600
No Lines 4 Trench Width 36" Max Trench Bottom Depth 36" Gravel Depth

☑ New System ☐ Repair ☐ Expansion System Type: I II (III) IV V VI
System Description: 25% Pump fm
Repair System Description: 25% Pump fm
Maintenance Agreement Required: ☐ Yes ☑ No

☐ House/Mod. Home ☐ Mobile Home ☐ Business ☐ Other
No. Bedrooms 4 No. Persons No. Employees


Water Supply: ☐ Individual ☑ Public ☐ Community

☐ Gravity ☐ Pressure ☐ Slab ☑ Crawl Space ☐ Basement w/plumbing ☐ Basement wo/plumbing


Comments/Conditions:

Comments/Conditions:
Install on Contour
Maintain all setbacks

INITIAL SITE SKETCH

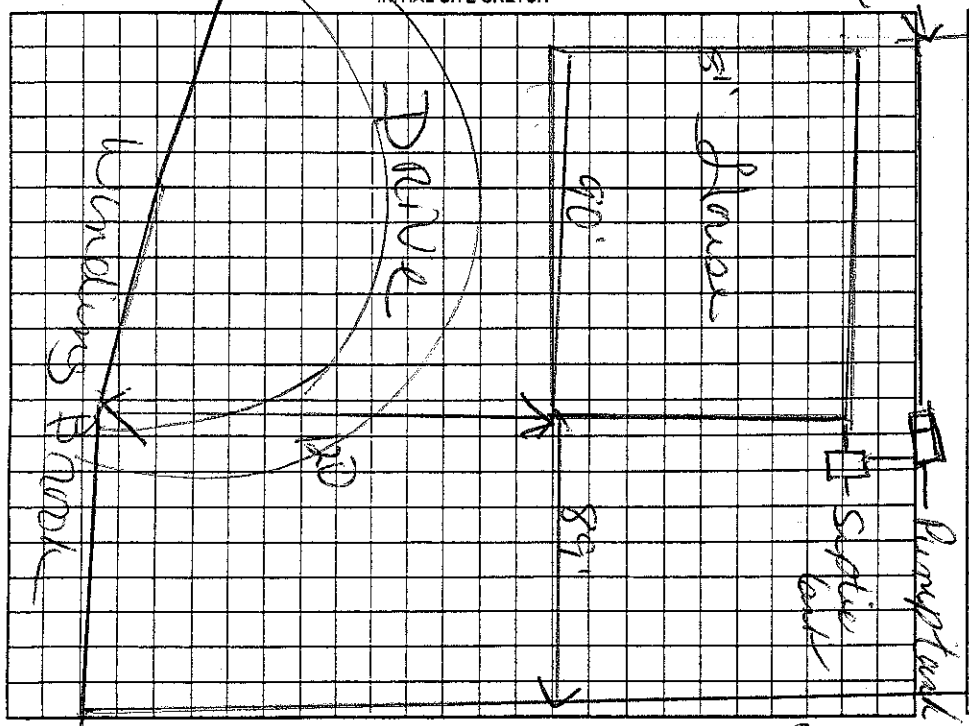

AS BUILT SKETCH

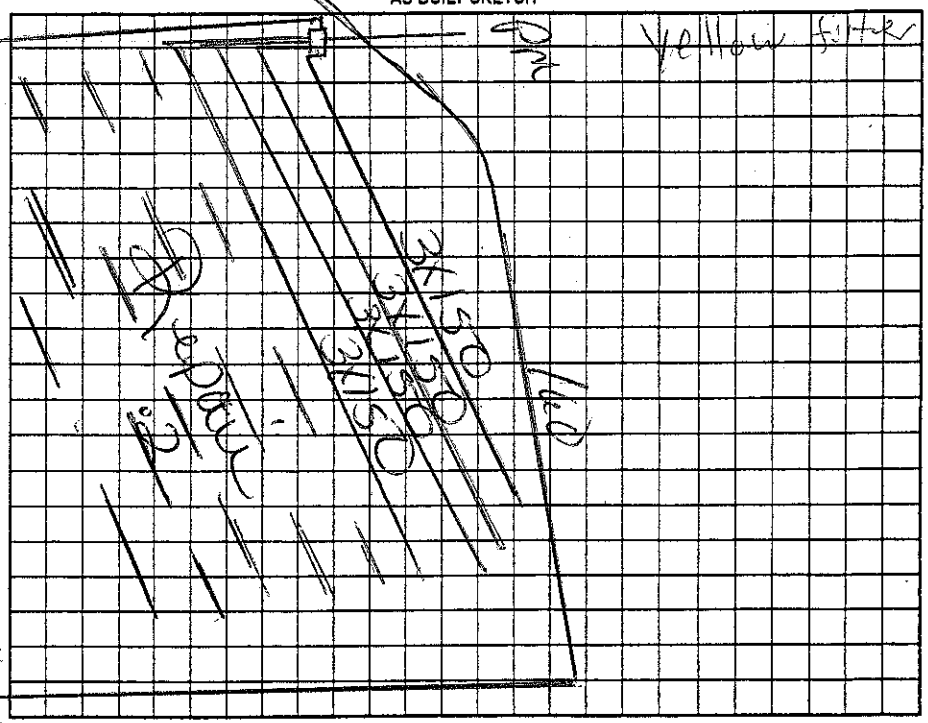

Permit can be suspended or revoked if any false information is supplied toward securing the permit/any unauthorized changes are made to the site/any unauthorized changes are made in the installation of the system. Improvement Permit with plat valid without expiration ☐ Improvement Permit with site plan valid for sixty months ☐ Authorization to Construct is valid for a period equal to that of Improvement Permit – not to exceed sixty months.

Signed: date 7-13-07 Installed by: David Hunter Grading

Improvement Permit by: date 7-13-07 Operation Permit by: date 3-24-08

Authorization to Construct by: date 7-13-07 Existing System Inspection by: date

HEALTH DEPT. COPY: WHITE OWNER COPY (FINAL): YELLOW OWNER COPY (INITIAL): PINK