IREDELL COUNTY HEALTH DEPARTMENT

STATESVILLE 704-878-5305 MOORESVILLE 704-664-5281

IMPROVEMENT PERMIT / AUTHORIZATION TO CONSTRUCT / OPERATION PERMIT / EXISTING SYSTEM INSPECTION

PERMIT# 13150 PIN# 4775148965 48865 DATE 6-19-08

OWNER OR APPLICANT Kerrigan Homes PHONE: Business 704-808-9400 Home

ADDRESS 570 Morrison Farm RD Troutman 28166

LOCATION 64E (R) Sain (R) Spring Forest (L) Howards Pond

SUBDIVISION Spring Forest BLOCK / SECTION LOT 14 LOT AREA .627 SITE CLASS. PS DESIGN FLOW 480 L.T.A.R. .3

Septic Tank: 1000 Gallons; STB 1012 Date 9-5-08
Pump Tank: 1000 Gallons; PT 1012 Date 1-15-09
Pump Make: Goulds Model PE 51 Serial No.
Nitrification Field: No Fields Square Feet 1600 Linear Feet 400
No Lines 4 Trench Width 36" Max Trench Bottom Depth 36" Gravel Depth

☑ New System ☐ Repair ☐ Expansion System Type: I II III IV V VI
System Description: 25% Red. Pump PM
Repair System Description: 50% Low Press
Maintenance Agreement Required: ☐ Yes ☐ No
☐ Gravity ☑ Pressure ☐ Slab ☐ Crawl Space ☐ Basement w/plumbing ☐ Basement wo/plumbing


☑ House/Mod. Home No. Bedrooms 4
☐ Mobile Home No. Persons
☐ Business No. Employees
☐ Other

Water Supply: ☐ Individual ☑ Public ☐ Community

Comments:/Conditions:

at end
1st line 8" soil
2nd line 8" soil
3rd line 6" soil
4th line 4" soil

INITIAL SITE SKETCH

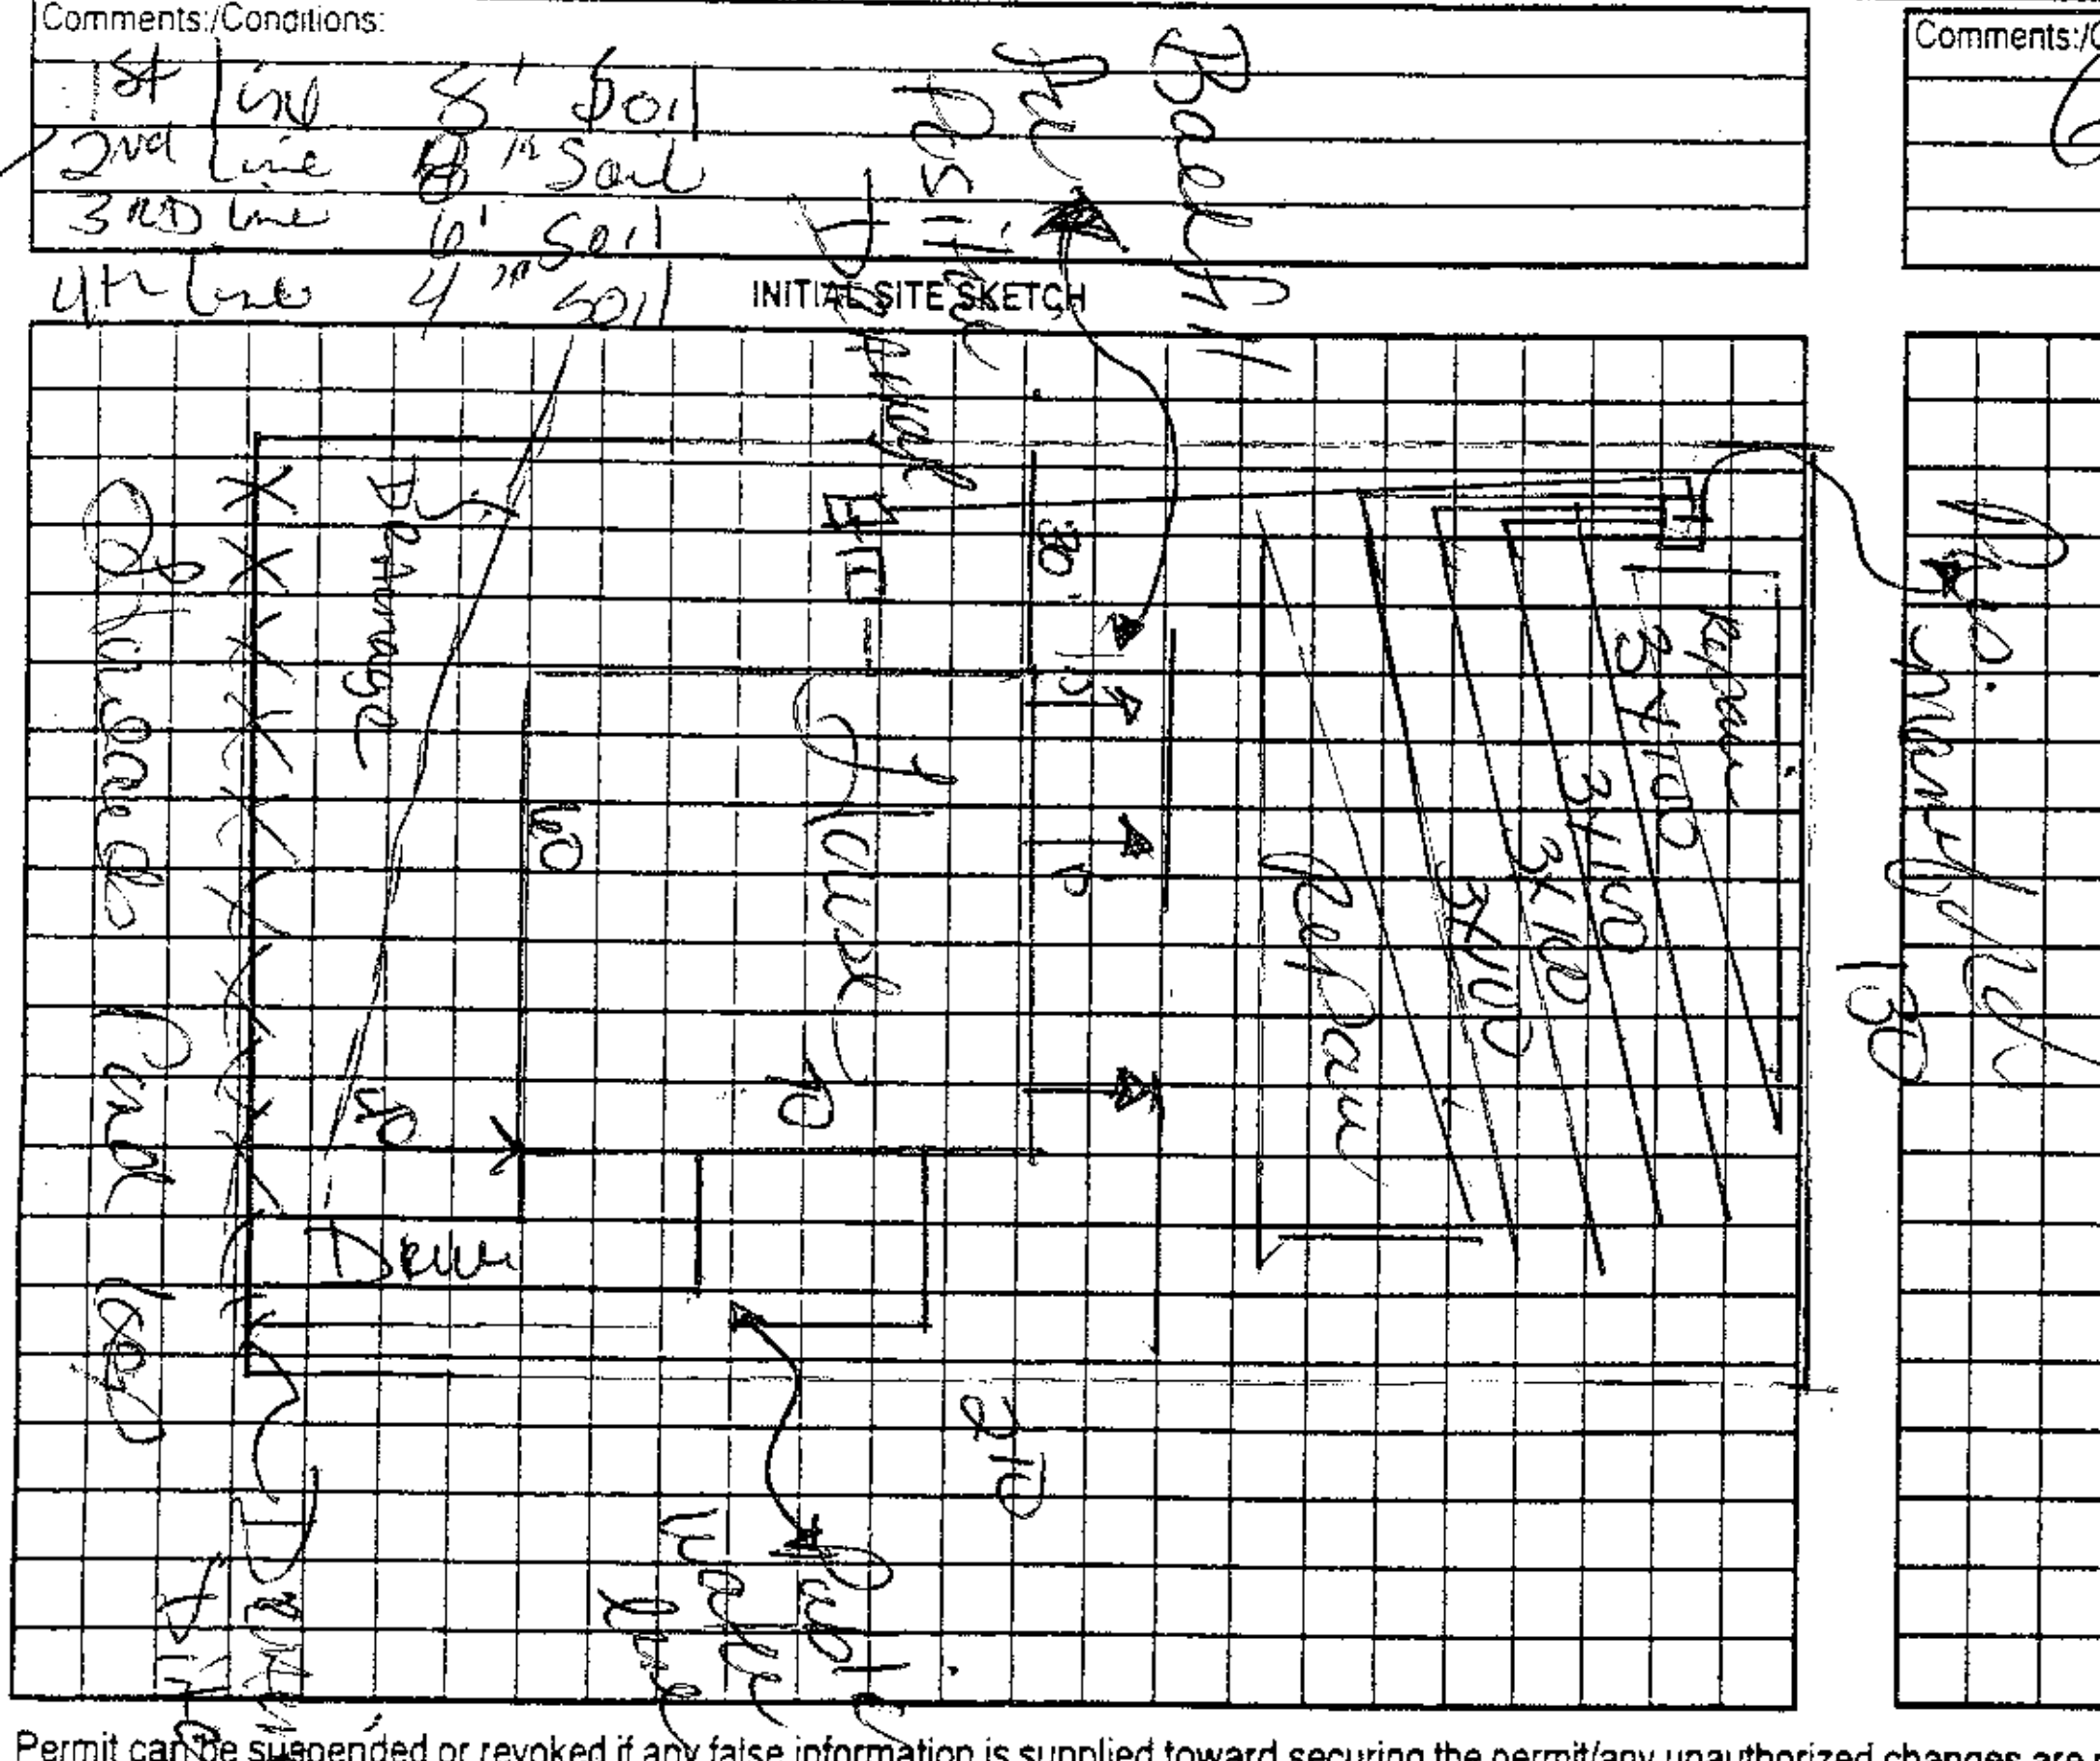

Comments:/Conditions:

Grade septic to even slope

AS BUILT SKETCH

Last 8-4" soil in each is clay, type much different than initial auger boring

5-6-08 Lines Checked (only)

5-19-09 Red Inf Tile
Septic make
Alarm on circuit good

Permit can be suspended or revoked if any false information is supplied toward securing the permit/any unauthorized changes are made to the site/any unauthorized changes are made in the installation of the system. Improvement Permit with plat valid without expiration ☐ Improvement Permit with site plan valid for sixty months ☑ Authorization to Construct is valid for a period equal to that of Improvement Permit – not to exceed sixty months.

Signed: [signature] date 6-19-08

Improvement Permit by: Kelly Cook date 6-19-08

Authorization to Construct by: Kelly Cook date 6-19-08

Installed by: Lucky Grading

Operation Permit by: Kelly Cook date 5-20-09

Existing System Inspection by: date

HEALTH DEPT. COPY: WHITE OWNER COPY (FINAL): YELLOW OWNER COPY (INITIAL): PINK