**IREDELL COUNTY HEALTH DEPARTMENT - *ENVIRONMENTAL HEALTH*** ☐ STATESVILLE OFFICE 704-878-5305 ☐ MOORESVILLE OFFICE 704-664-5281

**IMPROVEMENT PERMIT / AUTHORIZATION TO CONSTRUCT / OPERATION PERMIT / EXISTING SYSTEM INSPECTION**

PERMIT # REPAIR PIN # 4775-14-8965 DATE DECEMBER 3, 2010

OWNER SOUTHERN COMMUNITY BANK APPLICANT: COLDWELL BANKER UNITED PHONE: Home/Cell # 704-880-1312 Business # ~~336~~-794-7820

SITE ADDRESS 127 HOWARD POND LOOP, STVL. OWNER / APPLICANT ADDRESS 1602 DAVIE AV STATESVILLE, NC 28677


SITE DIRECTIONS US 64 EAST TL SAIN RD, TL HOWARD POND LOOP, SLIGHT LOT ON LEFT

SUBDIVISION SPRING FOREST BLOCK / SECTION ____ LOT # 44 LOT AREA 0.627 DESIGN FLOW 480 L.T.A.R. 0.3 (EX)


| | | | | | | | |
|---|---|---|---|---|---|---|---|
| Septic Tank EX | Gallons: STB | Date | ☐ New System ☑ Repair ☐ Expansion System Type I II (III) IV V VI | ☐ Residence ☐ Business | No. Bedrooms 4 | Water Supply |
| Pump Tank | Gallons: P T | Date | System Description: SUBSURFACE INTERCEPT W/PUMP BASIN | ☐ Other | No. Persons | ☐ Private |
| Pump Make | Model | Serial # | Repair System Description: 50% REDUCTION, LOW-PRESSURE | ☐ Slab | No. Employees | ☑ Public |
| No. Nitrification Fields: — | No. Lines — | Linear Feet — | Maintenance Agreement Required ☐ YES ☑ NO | ☐ Basement w/plumbing | ☐ Crawl Space | ☐ Community |
| Trench Width MIN 5" | MIN. Trench Bottom Depth 48"+ | Gravel Depth — | ☐ GRAVITY ☑ PRESSURE | ☐ Basement w/o plumbing | | |

Comments / Conditions CONSTRUCT 200 FOOT SUBSURFACE INTERCEPT DRAINAGE DITCH AT LOCATION SHOWN BEGINNING 48" DEEP MINIMUM, WITH MINIMUM 1% FALL ON DITCH BOTTOM, INTO SUMP BASIN

INITIAL SITE SKETCH

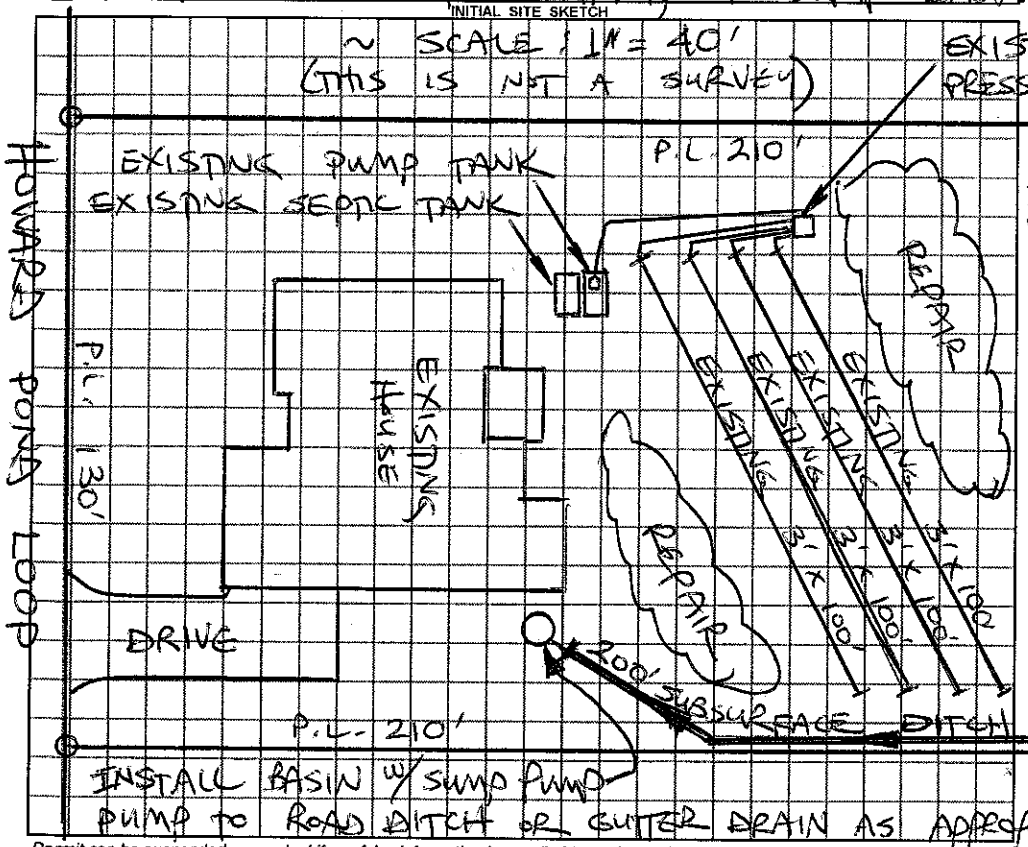


AS BUILT SKETCH

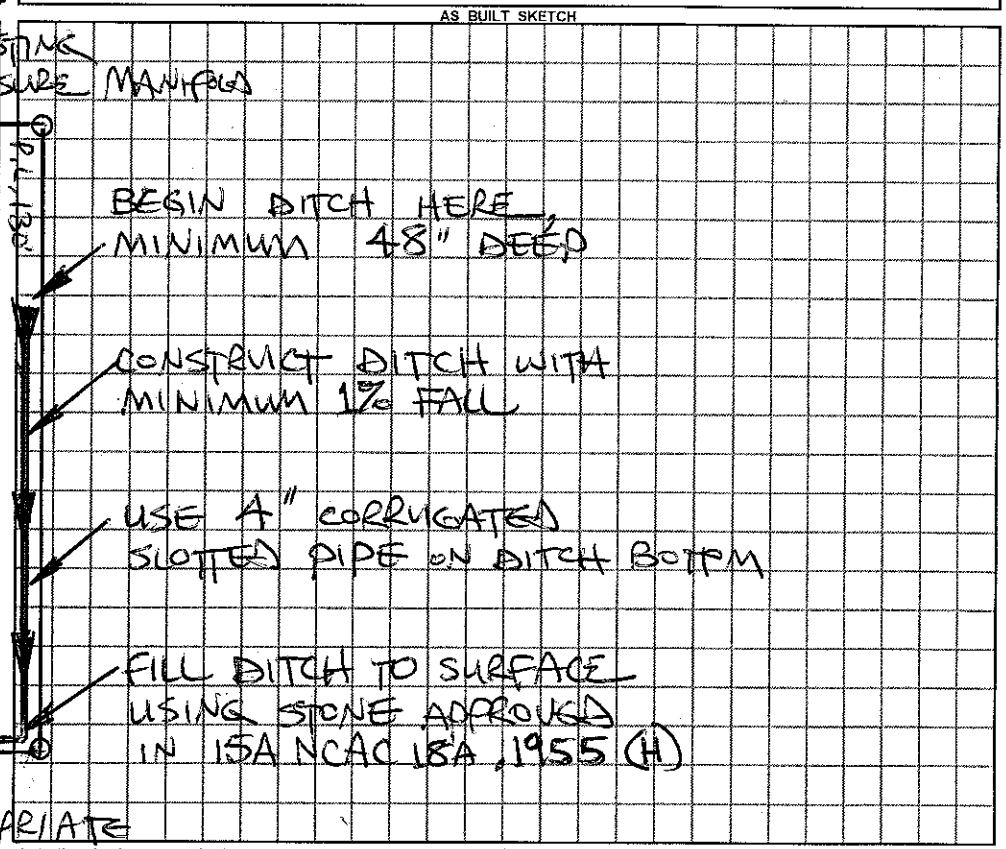


*Permit can be suspended or revoked if any false information is supplied toward securing the permit / any unauthorized changes are made to the site / any unauthorized changes are made in the installation of the system.*

☐ ***IMPROVEMENT PERMIT*** with plat valid without expiration. ☐ ***IMPROVEMENT PERMIT*** with plat valid without expiration. ☐ ***AUTHORIZATION TO CONSTRUCT*** valid for period equal to IMPROVEMENT PERMIT--not to exceed 60 mo.

Owner / Applicant Signature: _____ Date 12/3/10 Installed by: PIEDMONT BACKHOE SERVICE

IMPROVEMENT PERMIT by: STEVE HEDRICK REHS Date 12-3-2010 OPERATION PERMIT by: STEVE HEDRICK REHS Date 12-10-2010

AUTHORIZATION TO CONSTRUCT by: STEVE HEDRICK REHS Date 12-3-2010 Existing System Inspected by: _____ REHS Date _____

***YOU SHOULD CONTACT A LOCATOR SERVICE PRIOR TO ANY EXCAVATION***

White Copy – Environmental Health YELLOW COPY (Final) Owner / Applicant PINK COPY (Initial) Owner / Applicant