IREDELL COUNTY HEALTH DEPARTMENT

STATESVILLE 704-878-5305 MOORESVILLE 704-664-5281

CI

IMPROVEMENT PERMIT / AUTHORIZATION TO CONSTRUCT / OPERATION PERMIT / EXISTING SYSTEM INSPECTION

PERMIT# 104706 PIN# 4775-15-1128 DATE 02-15-02

OWNER OR CONTRACTOR TERRATEK INC PHONE: Business 704-902-0119 Home

ADDRESS 630 SIGNAL DRIVE EXT. STATESVILLE NC 28625

LOCATION 64 E, ① SAIN, ② SPRING FOREST DRIVE, ③ KNOLL CREST AT END IN CUL-DE-SAC

SUBDIVISION SPRING FOREST BLOCK / SECTION LOT 76 LOT AREA 0.8701 AC SITE CLASS PS DESIGN FLOW 360 L.T.A.R. .13

Septic Tank: 1000 Gallons: STB 1012 Date 6-25-02
Pump Tank: Gallons: PT Date
Pump Make: Model Serial No.
Nitrification Field: No Fields 1 Square Feet 1200' Linear Feet 400'
No Lines 4X100' Trench Width 36" Max Trench Bottom Depth 36" Gravel Depth 12"

☒ New System ☐ Repair System Type: I (II) III. IV. V. VI
System Description: CONV GRAV
Repair System Description: GRAV 25% REDUCT
Maintenance Agreement Required: ☐ Yes ☒ No

☒ House/Mod. Home No. Bedrooms 3
☐ Mobile Home No. Bathrooms 2.5
☐ Business No. Employees
☐ Other


☐ Slab ☒ Crawl Space ☐ Basement w/plumbing ☐ Basement wo/plumbing

Water Supply: ☐ Individual ☒ Public ☐ Community


Comments:/Conditions: ① MAINTAIN SETBACKS ② INSTALL LINES ON CONTOURS

Comments:/Conditions: POLYLOK FILTER & RISERS INSTALLED AS SHOWN

INITIAL SITE SKETCH

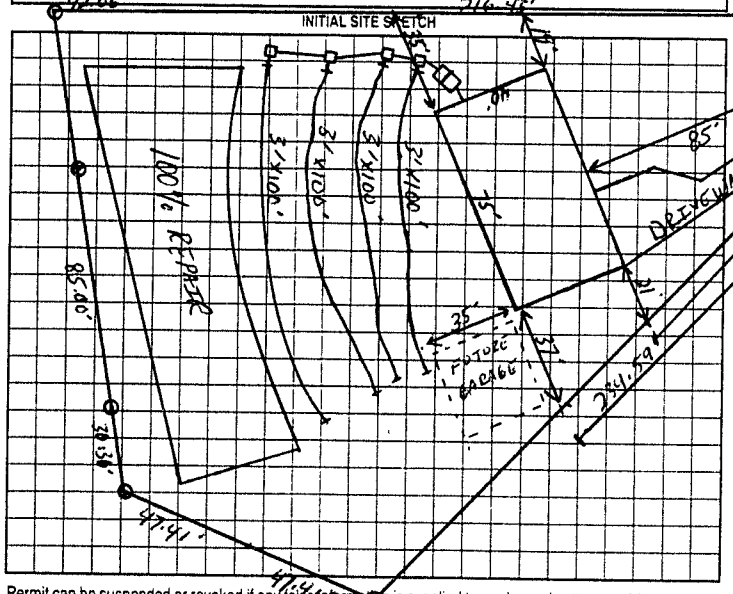

AS BUILT SKETCH

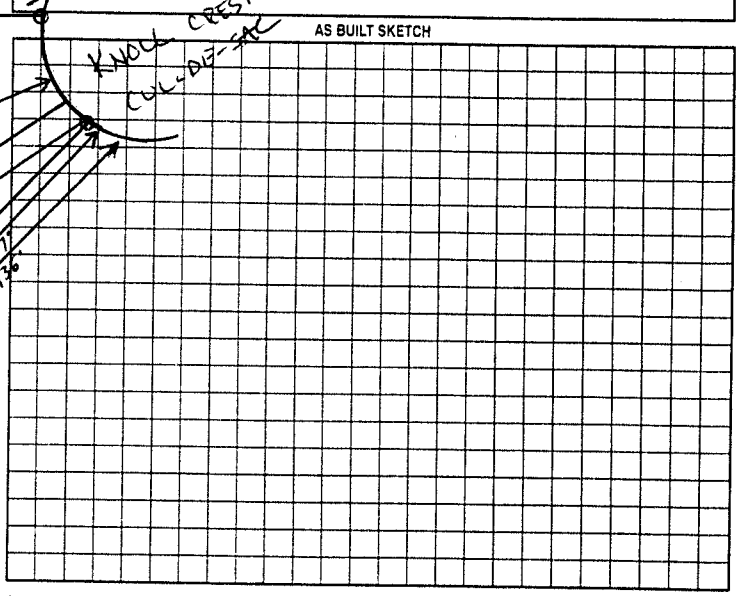

Permit can be suspended or revoked if any false information is supplied toward securing the permit/any unauthorized changes are made to the site/any unauthorized changes are made in the installation of the system. Improvement Permit with plat valid without expiration. Improvement Permit with site plan valid for sixty months. Authorization to Construct is valid for a period equal to that of Improvement Permit – not to exceed sixty months.

Signed: date 02-15-02 Installed by: DAVID YOUNTZ

Improvement Permit by: date 02-15-02 Operation Permit by: date 8-30-02

Authorization to Construct by: date 02-15-02 Existing System Inspection by: date

HEALTH DEPT. COPY: WHITE OWNER COPY (FINAL): YELLOW OWNER COPY (INITIAL): PINK