IREDELL COUNTY HEALTH DEPARTMENT

STATESVILLE 704-878-5305 (61) MOORESVILLE 704-664-5281

IMPROVEMENT PERMIT / AUTHORIZATION TO CONSTRUCT / OPERATION PERMIT / EXISTING SYSTEM INSPECTION

PERMIT# 126171 PIN# 4775-15-1714 DATE 3-16-05

OWNER OR CONTRACTOR R. E. FOY PHONE: Business 828-312-5421 Home

ADDRESS 84 CALLAWAY DRIVE, TAYLORSVILLE, NC 28681

LOCATION US 64 EAST, TL SAIN ROAD, TL SPRING FOREST DRIVE, 2ND ON RIGHT PAST KNOLLCREST LANE

SUBDIVISION SPRING FOREST BLOCK / SECTION LOT 89 LOT AREA 0.6910 ACRE SITE CLASS. PS1 DESIGN FLOW 360 L.T.A.R. 0.25 GPD/FT²

Septic Tank: 1000 Gallons; STB 160 Date 9-27-05
Pump Tank: Gallons; PT Date
Pump Make: Model Serial No.
Nitrification Field: No Fields 1 Square Feet EQ. TO 1440 Linear Feet 240
No Lines FIVE Trench Width 24" Max Trench Bottom Depth 36"

☑ New System ☐ Repair System Type: I, II, III, IV, V, VI
System Description: 50% REDUCTION GRAVITY
Repair System Description: 50% REDUCTION, LOW PRESSURE
Maintenance Agreement Required: ☐ Yes ☑ No
Depth SAND 24" ☐ Slab ☐ Crawl Space ☑ Basement w/plumbing ☐ Basement wo/plumbing


☑ House/Mod. Home No. Bedrooms 3
☐ Mobile Home No. Bathrooms
☐ Business No. Employees
☐ Other

Water Supply: ☐ Individual ☑ Public ☐ Community


Comments/Conditions: ① INSTALL 50% REDUCTION SYSTEM USING 60 PPBPS PANELS ON CONTOUR AS SHOWN ② CONTACT HEALTH DEPT. AFTER CLEARING TO FLAG-OUT SYSTEM, ③ USE ONE EFFLUENT SPLITTER (SUCH AS "ZOELLAR TRU-FLO") TO ACHIEVE EQUAL DISTRIBUTION

Comments/Conditions: SYSTEM INSTALLED USING TANK MARKER AND "ZABEL" FILTER

INITIAL SITE SKETCH SCALE: 1"=40'

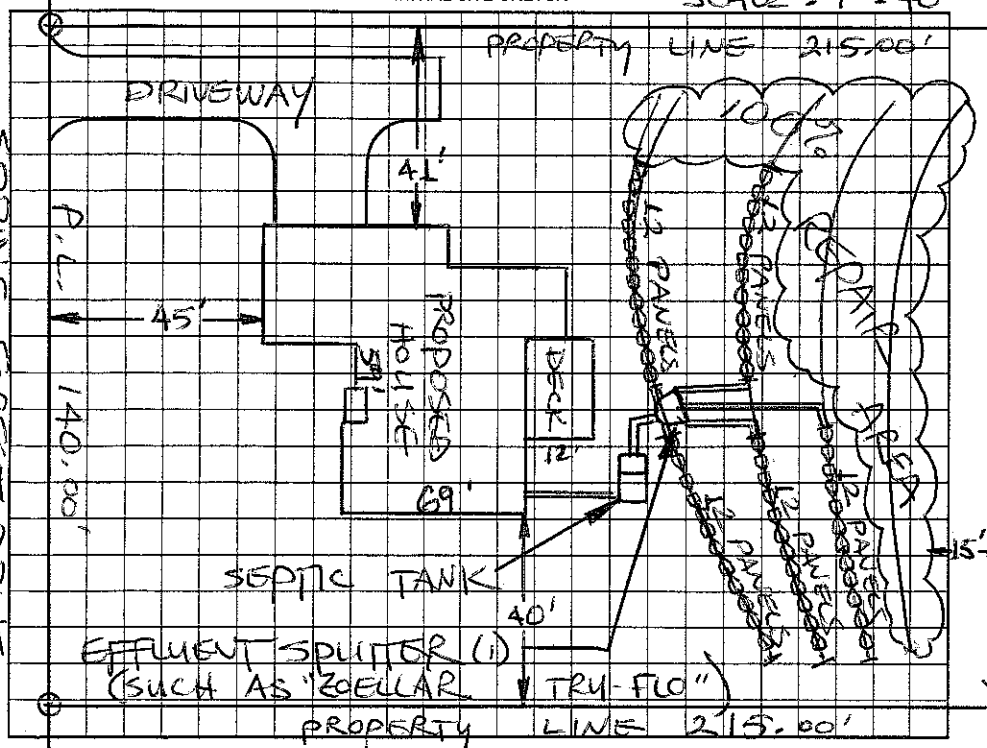

AS BUILT SKETCH

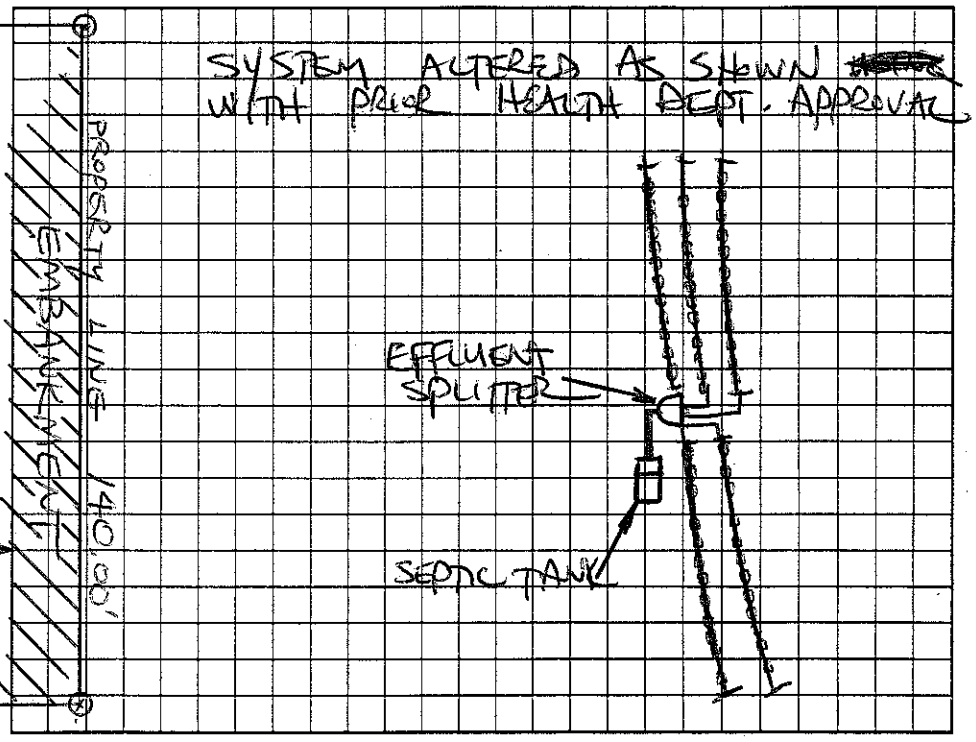

Permit can be suspended or revoked if any false information is supplied toward securing the permit/any unauthorized changes are made to the site/any unauthorized changes are made in the installation of the system. Improvement Permit with plat valid without expiration. Improvement Permit with site plan valid for sixty months. Authorization to Construct is valid for a period equal to that of Improvement Permit – not to exceed sixty months.

Signed: R. E. Foy date 3/22/05 Installed by: TOMMY COTHREN

Improvement Permit by: STEVE HEDRICK date 3-16-05 Operation Permit by: STEVE HEDRICK date 2-3-06

Authorization to Construct by: STEVE HEDRICK date 3-16-05 Existing System Inspection by: date

HEALTH DEPT. COPY: WHITE OWNER COPY (FINAL): YELLOW OWNER COPY (INITIAL): PINK