IREDELL COUNTY HEALTH DEPARTMENT

STATESVILLE 704-878-5305 (C) MOORESVILLE 704-664-5281

IMPROVEMENT PERMIT / AUTHORIZATION TO CONSTRUCT / OPERATION PERMIT / EXISTING SYSTEM INSPECTION

PERMIT# 09445 PIN# ~~4775-14-3899~~ 4775-15-3063 DATE 12-31-02

OWNER OR CONTRACTOR TERRATEK PHONE: Business 704-902-0119 Home 704-878-6633

ADDRESS 630 SIGNAL HILL DRIVE EXT STATESVILLE, NC 28625

LOCATION 64 E, (L) SAIN, (L) SPRING FOREST (L) HOWARDS POND, LOT # 66 ON RT PAST CURVE

SUBDIVISION SPRING FOREST BLOCK / SECTION ____ LOT 66 LOT AREA 1.66 SITE CLASS. PS DESIGN FLOW 360 L.T.A.R. ~~.30~~ .30

Septic Tank: 1000 Gallons; STB 10/2 Date 2-5-03

Pump Tank: ____ Gallons; PT ____ Date ____

Pump Make: ____ Model ____ Serial No. ____

Nitrification Field: No Fields 1 Square Feet 1440 Linear Feet ~~480~~ 540

No Lines 6 Trench Width 36" ~~Min~~ Max Trench Bottom Depth 30"

☒ New System ☐ Repair System Type: I, II, III, IV, V, VI

System Description: CONV GRAV

Repair System Description: LD PANEL

Maintenance Agreement Required: ☐ Yes ☒ No

Gravel Depth 12"

☒ House/Mod. Home No. Bedrooms ~~3~~ 4

☐ Mobile Home No. Bathrooms ~~2~~ 2½

☐ Business No. Employees ____

☐ Other ____


☐ Slab ☒ Crawl Space ☐ Basement w/plumbing ☐ Basement wo/plumbing

Water Supply: ☐ Individual ☒ Public ☐ Community

Comments/Conditions: (1) SEVERAL HOUSE PLANS ATTACHED. UNDECIDED ON WHICH ONE. 75'x40' HOUSE STAKED OUT ON THE SITE. ISSUED IP ONLY.

Comments/Conditions: (2) MAINTAIN SETBACKS (3) INSTALL LINES ON CONTOUR (4) NOTE MINIMUM TRENCH BOTTOM DEPTH IS 30" DEEP. THE REGIONAL SOIL SCIENTIST, GENE YOUNTZ FROM NCDENR, VISITED THE SITE & GAVE THE L.T.A.R.

INITIAL SITE SKETCH 1" ≈ 50'

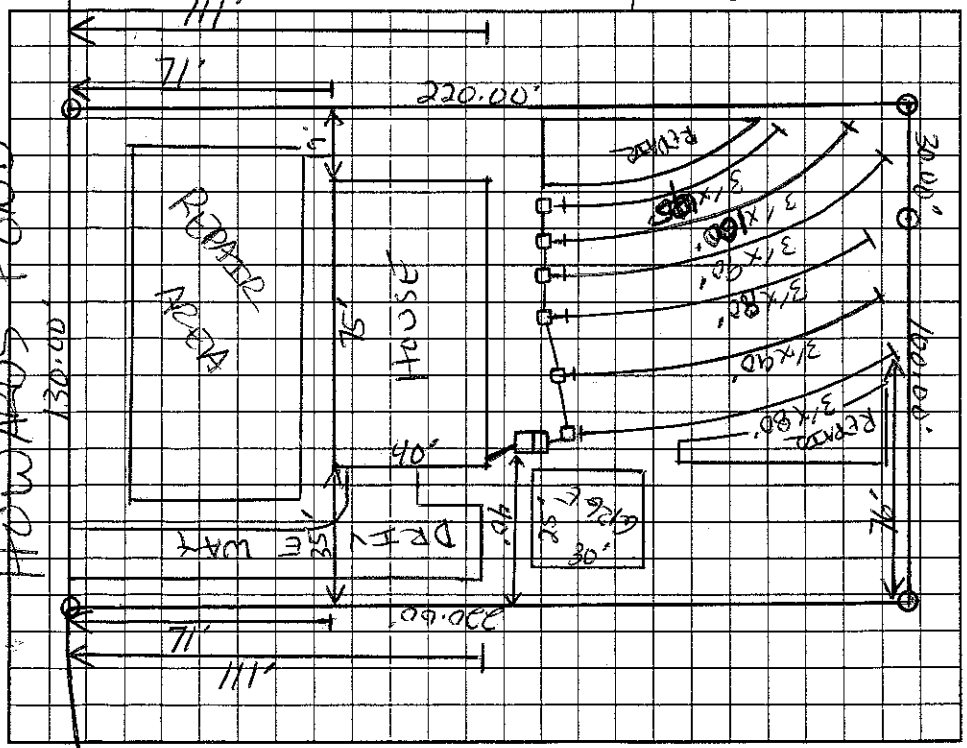

AS BUILT SKETCH

(1) SEPTIC TANK WITH MARKER INSTALLED USING "TUFTITE" FILTER

(2) SYSTEM EXPANDED AS SHOWN TO ACCOMODATE 4 BR HOUSE

Permit can be suspended or revoked if any false information is supplied toward securing the permit/any unauthorized changes are made to the site/any unauthorized changes are made in the installation of the system. Improvement Permit with plat valid without expiration. Improvement Permit with site plan valid for sixty months. Authorization to Construct is valid for a period equal to that of Improvement Permit – not to exceed sixty months.

Signed: ____ date 2/14/03 Installed by: DAVID YOUNTZ

Improvement Permit by: ____ date 01-03-03 Operation Permit by: STEVE HENDRICK date 8-15-03

Authorization to Construct by: ____ date 2/14/03 Existing System Inspection by: ____ date ____

HEALTH DEPT. COPY: WHITE OWNER COPY (FINAL): YELLOW OWNER COPY (INITIAL): PINK