IREDELL COUNTY HEALTH DEPARTMENT

STATESVILLE 704-878-5305 MOORESVILLE 704-664-5281

CI

IMPROVEMENT PERMIT / AUTHORIZATION TO CONSTRUCT / OPERATION PERMIT / EXISTING SYSTEM INSPECTION

PERMIT# 108825 PIN# 4775-15-4364 DATE 09-23-02

OWNER OR CONTRACTOR CCS INC / RICHARD WOOD PHONE: Business 704-881-0510 Home 704-682-1727

ADDRESS 130 DOBBS DR STATESVILLE, NC 28625

LOCATION 64 EAST, (C) SAIN, (L) SPRING FORREST DR., (L) KNOLLCREST, LOT # 73 ON LEFT

SUBDIVISION SPRING FORREST BLOCK / SECTION ____ LOT 73 LOT AREA .6423 SITE CLASS PS DESIGN FLOW 360 L.T.A.R. .25

Septic Tank: 1000 Gallons; STB 1017 Date 9-25-02

Pump Tank: ____ Gallons; PT ____ Date ____

Pump Make: ____ Model ____ Serial No. ____

Nitrification Field: No Fields 1 Square Feet EQ=1440' Linear Feet 360'

No Lines 5x72' Trench Width 36" Max Trench Bottom Depth 36" Gravel Depth 12"

[X] New System [ ] Repair System Type: I, II, (III), IV, V, VI

System Description: GRAV 250/0 RED

Repair System Description: LP PANEL

Maintenance Agreement Required: [ ] Yes [X] No

[X] House/Mod. Home No. Bedrooms 3

[ ] Mobile Home No. Bathrooms 2

[ ] Business No. Employees ____

[ ] Other ____


[ ] Slab [X] Crawl Space [ ] Basement w/plumbing [ ] Basement wo/plumbing

Water Supply: [ ] Individual [X] Public [ ] Community

Comments:/Conditions: (1) CHANGED TO FRONT ENTRY GARAGE WITH APPLICANTS APPROVAL (2) LINES + HOUSE ARE COMPLETELY FLAGGED OUT (3) MAINTAIN SETBACKS + INSTALL LINES ON CONTOURS (4) INSTALL FRENCH DRAIN 48" DEEP TO DAYLIGHT.

Comments:/Conditions: DAYLIGHT. TUFF TITE FILTER & MANIFOLD INSTALLED AS SHOWN. NEEDS F/D CHECKED. LC 4-4-03

INITIAL SITE SKETCH

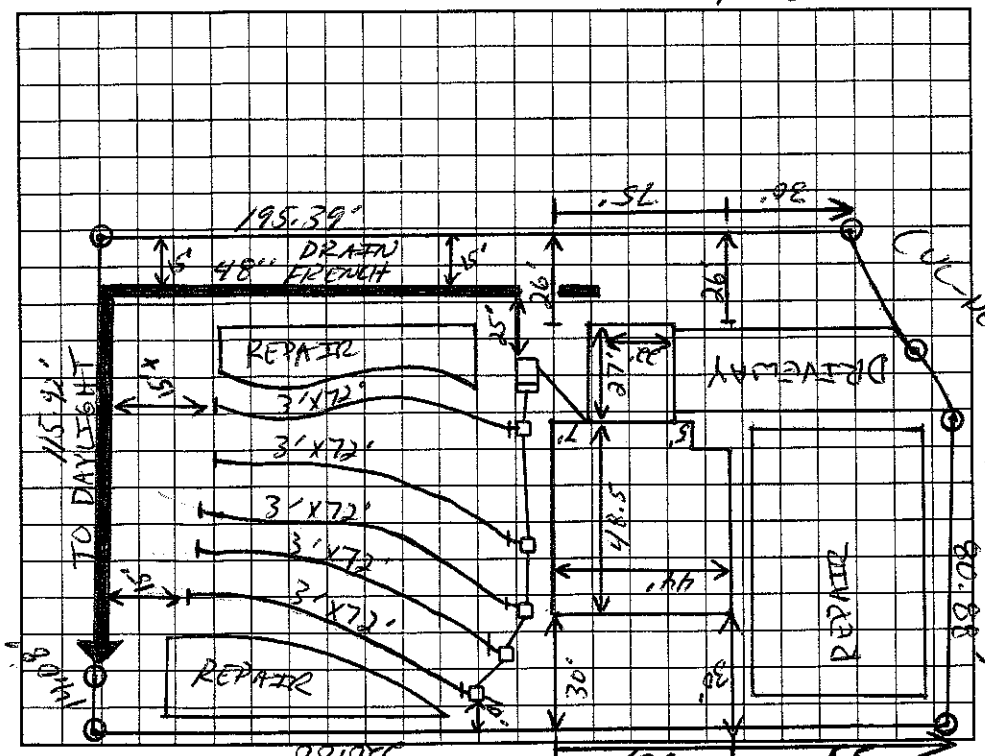

AS BUILT SKETCH

1=80
2=70
3=80
4=70
5=60

LINE LENGTHS / EQ'S FLOW INSTALLED

ON 5-2-03 W/D FRENCH DRAIN. BEEN 28 DAYS TUFF TITE W/D. DUG DOWN TO END OF FIRST LINE & SECOND LINE. TO WAS EXACTLY 15' SLOPE SETBACK TO LINES. LC 5-2-03

Permit can be suspended or revoked if any false information is supplied toward securing the permit/any unauthorized changes are made to the site/any unauthorized changes are made in the installation of the system. Improvement Permit with plat valid without expiration. Improvement Permit with site plan valid for sixty months. Authorization to Construct is valid for a period equal to that of Improvement Permit – not to exceed sixty months.

Signed: [signature] date 9-24-02

Improvement Permit by: [signature] RS date 9-23-02

Authorization to Construct by: [signature] RS date 9-23-02

Installed by: CRAIG THOMPSON

Operation Permit by: [signature] PS date 5-2-03

Existing System Inspection by: ____ date ____

HEALTH DEPT. COPY: WHITE OWNER COPY (FINAL): YELLOW OWNER COPY (INITIAL): PINK