IREDELL COUNTY HEALTH DEPARTMENT

STATESVILLE 704-878-5305 MOORESVILLE 704-664-5281

IMPROVEMENT PERMIT / AUTHORIZATION TO CONSTRUCT / OPERATION PERMIT / EXISTING SYSTEM INSPECTION

PERMIT# 151475 PIN# 4773154497 DATE 7-11-08

OWNER OR APPLICANT R. Wood Construction, Inc. PHONE: Business 704-924-8635 Home

ADDRESS 111 Knollcrest Lane Statesville, NC 28625

LOCATION 64 E (L) SAIN RD (R) Spring Forest Drive at Corner of Knollcrest & Spring Forest

SUBDIVISION Spring Forest BLOCK / SECTION LOT 12 LOT AREA .668 SITE CLASS. PS DESIGN FLOW 360 L.T.A.R. .3

Septic Tank: 1000 Gallons; STB 825 Date 9-2-

Pump Tank: 1000 Gallons; PT 302 Date 9-5-08

Pump Make: Model Serial No.

Nitrification Field: No Fields Square Feet 1200 Linear Feet 200

No Lines 4 Trench Width 24" Max Trench Bottom Depth 36" Gravel Depth

☑ New System ☐ Repair ☐ Expansion System Type: I II (III) IV V VI

System Description: 50% pump → PM

Repair System Description: 50% Pump → PM

Maintenance Agreement Required: ☐ Yes ☑ No

☐ Gravity ☑ Pressure ☐ Slab ☐ Crawl Space ☑ Basement w/plumbing ☐ Basement wo/plumbing

☑ House/Mod. Home ☐ Mobile Home ☐ Business ☐ Other


No. Bedrooms 3 No. Persons No. Employees

Water Supply: ☐ Individual ☐ Public ☐ Community

Comments:/Conditions:

Comments:/Conditions: Install on Contour. Maintain all setbacks

INITIAL SITE SKETCH

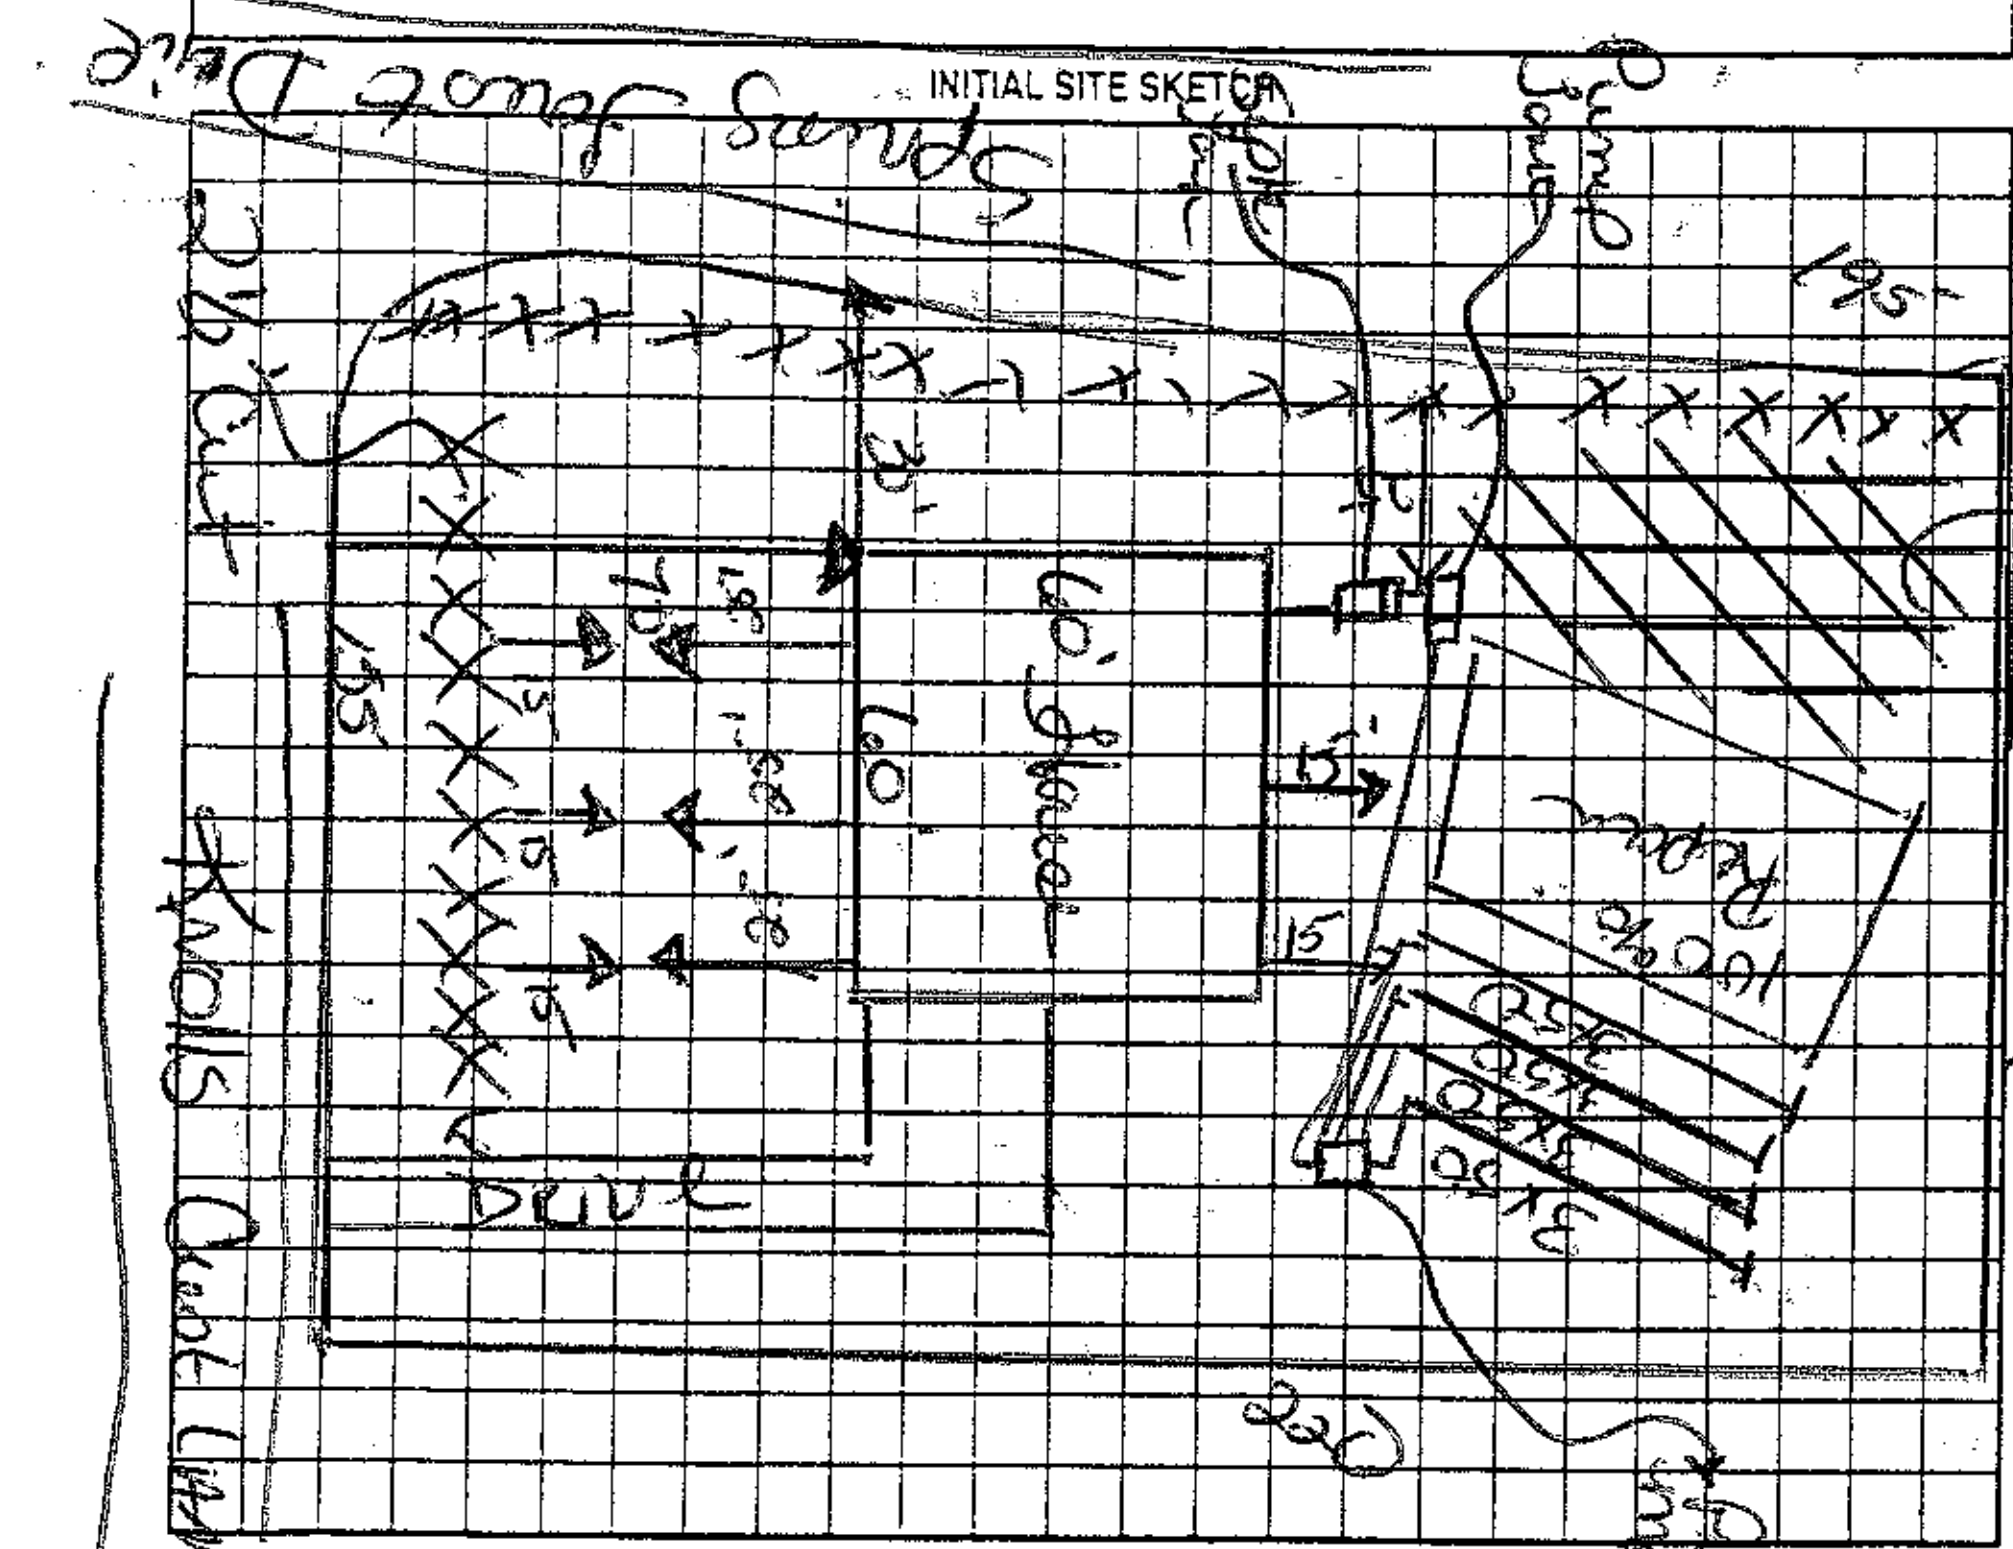

AS BUILT SKETCH

Permit can be suspended or revoked if any false information is supplied toward securing the permit/any unauthorized changes are made to the site/any unauthorized changes are made in the installation of the system. Improvement Permit with plat valid without expiration ☐ Improvement Permit with site plan valid for sixty months ☑ Authorization to Construct is valid for a period equal to that of Improvement Permit – not to exceed sixty months.

Signed: [signature] date 7/11/08

Improvement Permit by: Kelly Cook date 7-11-08

Authorization to Construct by: Kelly Cook date 7-11-08

Installed by: Rowan Septic

Operation Permit by: [signature] date 12-9-08

Existing System Inspection by: date

HEALTH DEPT. COPY: WHITE OWNER COPY (FINAL): YELLOW OWNER COPY (INITIAL): PINK