IREDELL COUNTY HEALTH DEPARTMENT

STATESVILLE 704-878-5305 MOORESVILLE 704-664-5281

IMPROVEMENT PERMIT / AUTHORIZATION TO CONSTRUCT / OPERATION PERMIT / EXISTING SYSTEM INSPECTION

PERMIT# 92676 PIN# 4775 14 0974 DATE 10/27/00

OWNER OR CONTRACTOR Todd Ellis Builders PHONE: Business 878-6633 Home

ADDRESS 315 Seven Springs Statesville NC 28625

LOCATION 64 E, L Sain, L Spring Forest Dr, L Howard Pond LP, on Rt

SUBDIVISION Spring Forest BLOCK / SECTION — LOT 68 LOT AREA 0.66 AC SITE CLASS PS DESIGN FLOW 360 L.T.A.R. 0.5

Septic Tank: 1000 Gallons; STB 1012 Date 10-10-2000
Pump Tank: Gallons; PT Date
Pump Make: Model Serial No
Nitrification Field: No Fields 1 Square Feet 1200 Linear Feet 400
No Lines 5 Trench Width 36" Max Trench Bottom Depth 36" Gravel Depth 12"

[X] New System [ ] Repair System Type: I, II, III, IV, V, VI
System Description: Gravity Conventional
Repair System Description: Grav/Pump 25% Red
Maintenance Agreement Required: [ ] Yes [X] No


[X] House/Mod Home No. Bedrooms 3
[ ] Mobile Home No. Bathrooms 2
[ ] Business No. Employees
[ ] Other
[ ] Slab [X] Crawl Space [ ] Basement w/plumbing [ ] Basement wo/plumbing

Water Supply: [ ] Individual [X] Public [ ] Community


Comments/Conditions:

Comments/Conditions: SYSTEM INSTALLED AS SHOWN WITH POLYLOK FILTER FABRICS

INITIAL SITE SKETCH

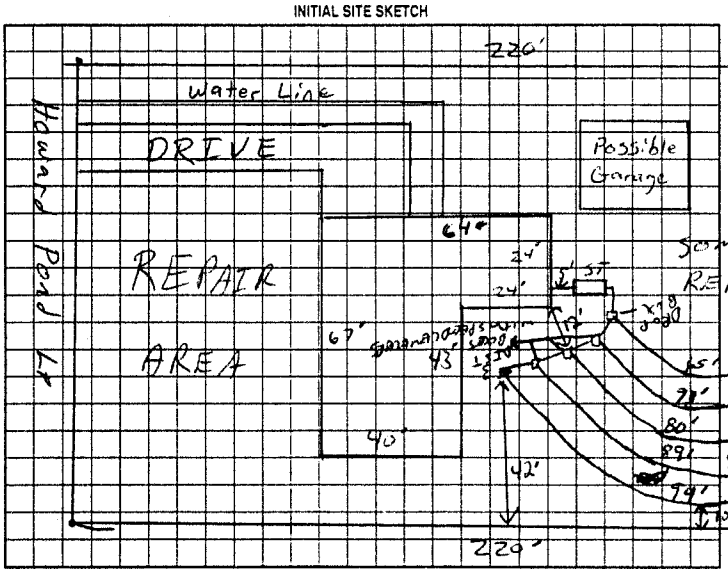

AS BUILT SKETCH

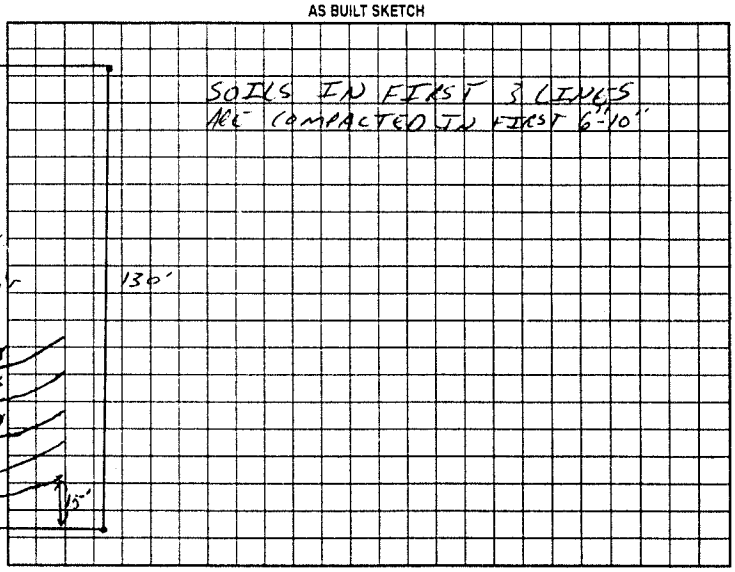

Permit can be suspended or revoked if any false information is supplied toward securing the permit/any unauthorized changes are made to the site/any unauthorized changes are made in the installation of the system. Improvement Permit with plat valid without expiration. Improvement Permit with site plan valid for sixty months. Authorization to Construct is valid for a period equal to that of Improvement Permit – not to exceed sixty months.

Signed: date 10/1/00 Installed by: COUNTY GRADING

Improvement Permit by: RSI date 10/27/00 Operation Permit by: RSI date 5-8-01

Authorization to Construct by: RSI date 10/27/00 Existing System Inspection by: date

HEALTH DEPT. COPY WHITE OWNER COPY (FINAL) YELLOW OWNER COPY (INITIAL) PINK