IREDELL COUNTY HEALTH DEPARTMENT

STATESVILLE 704-878-5305 MOORESVILLE 704-664-5281

IMPROVEMENT PERMIT / AUTHORIZATION TO CONSTRUCT / OPERATION PERMIT / EXISTING SYSTEM INSPECTION

PERMIT# 126235 PIN# 4775-15-9221 DATE 3-11-05

OWNER OR CONTRACTOR BROOME BUILDERS INC PHONE: Business 704-902-2057 Home 704-309-0338

ADDRESS P.O. Box 248 TROUTMAN NC 28166

LOCATION US 64 EAST TL SAIN RD, TL SPRING FOREST DR, TL HOWARD POND LOOP, 3RD LOT on LEFT

SUBDIVISION SPRING FOREST BLOCK / SECTION ____ LOT 42 LOT AREA 0.6267 ACRE SITE CLASS. PS DESIGN FLOW 360 L.T.A.R. 0.25 GPD/FT²

Septic Tank: 1000 Gallons; STB 1012 Date 1-22-05

Pump Tank: ____ Gallons; PT ____ Date ____

Pump Make: ____ Model ____ Serial No. ____

Nitrification Field: No Fields 1 Square Feet EQ TO 1440 Linear Feet 360

No Lines FIVE Trench Width 36" Max Trench Bottom Depth 36" Gravel Depth N/A

☑ New System ☐ Repair System Type: I, II, (III), IV, V, VI

System Description: 25% REDUCTION GRAVITY

Repair System Description: 50% REDUCTION, LOW PRESSURE

Maintenance Agreement Required: ☐ Yes ☑ No

☑ House/Mod. Home No. Bedrooms 3

☐ Mobile Home No. Bathrooms ____

☐ Business No. Employees ____

☐ Other ____


☐ Slab ☑ Crawl Space ☐ Basement w/plumbing ☐ Basement wo/plumbing

Water Supply: ☐ Individual ☑ Public ☐ Community


Comments:/Conditions: INSTALL 25% REDUCTION SYSTEM ON CONTOUR AS FLAGGED

Comments:/Conditions: ① SEPTIC TANK WITH MARKER INSTALLED USING "TUFTAPE" FILTER ② SYSTEM ALTERED AS SHOWN WITHOUT PRIOR HEALTH DEPT. APPROVAL USING 90 "QUICK-4" CHAMBERS

INITIAL SITE SKETCH SCALE: 1" = 40'

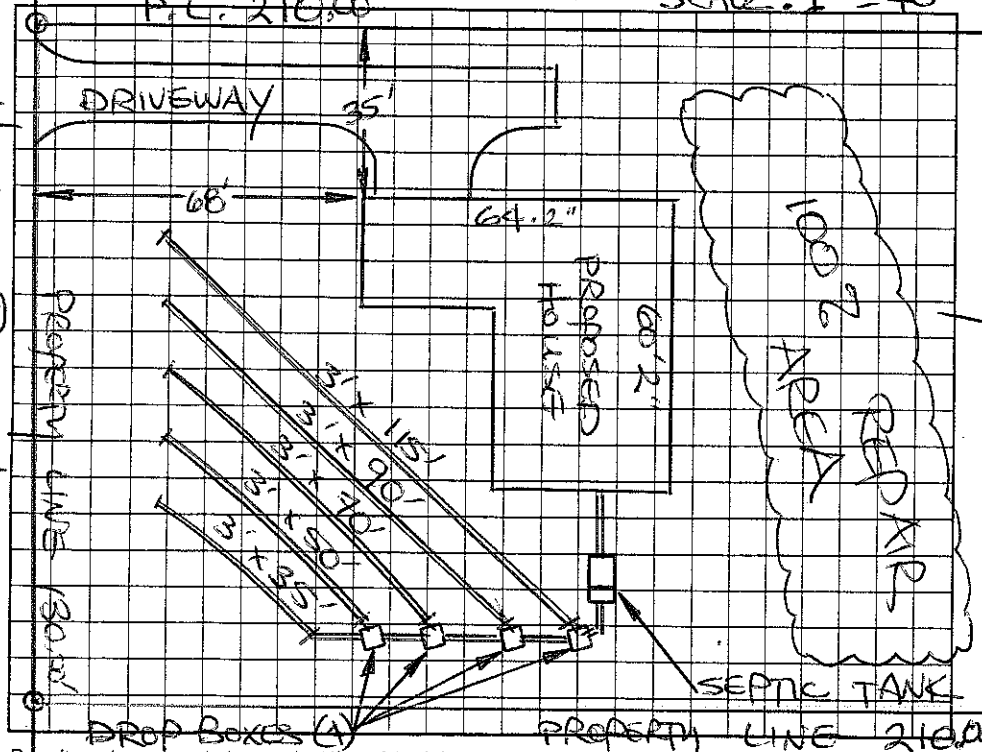

AS BUILT SKETCH

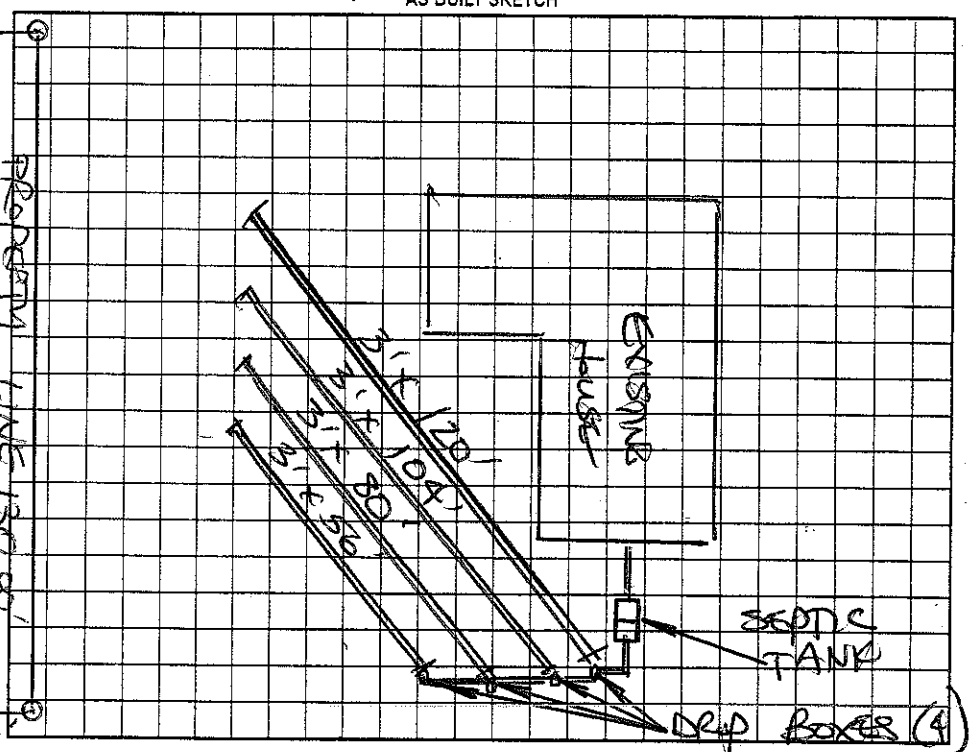

Permit can be suspended or revoked if any false information is supplied toward securing the permit/any unauthorized changes are made to the site/any unauthorized changes are made in the installation of the system. Improvement Permit with plat valid without expiration. Improvement Permit with site plan valid for sixty months. Authorization to Construct is valid for a period equal to that of Improvement Permit – not to exceed sixty months.

Signed: Randy Broome date 3/15/05

Improvement Permit by: STEVE HENRICK date 3-11-05

Authorization to Construct by: STEVE HENRICK date 3-11-05

Installed by: TOMMY FRYE

Operation Permit by: STEVE HENRICK date 7-22-05

Existing System Inspection by: ____ date ____

HEALTH DEPT. COPY: WHITE OWNER COPY (FINAL): YELLOW OWNER COPY (INITIAL): PINK