IREDELL COUNTY HEALTH DEPARTMENT

STATESVILLE 704-878-5305 MOORESVILLE 704-664-5281

43419

IMPROVEMENT PERMIT / CERTIFICATE OF COMPLETION / OPERATION PERMIT / EXISTING SYSTEM INSPECTION

PROPERTY DESCRIPTION NO. 14686 DATE 9-27-93

OWNER OR CONTRACTOR William A. White PHONE: Business Home

ADDRESS TAX MAP NO. 5R-A-35

LOCATION 645 TR NewSalemChRd 1/2 mi on left. back off Road

SUBDIVISION BLOCK / SECTION LOT LOT AREA 9+ acres SITE CLASS. PS. L.T.A.R. .3

Water Supply: ☑ Individual ☐ Community ☐ Public Iredell Co. water

Septic Tank: 1500 Gallons; STB 797 Date 8-2-93

Pump Tank: Gallons; PT Date

Nitrification Field: No Fields 1 Square Feet 2250 Linear Feet 750

No Lines 5 Trench Width 36 Trench Depth 24 Gravel Depth 12

☑ New System ☐ Repair System Type: I. II. III. IV. V. VI

System Description: Conv. Gravity

Repair System Description: " "

Maintenance Agreement Required: ☐ Yes ☑ No

☑ House/Mod. Home ☐ Mobile Home ☐ Business ☐ Other

No. Bedrooms 5 No. Bathrooms 4½ No. Employees

☐ Slab ☐ Crawl Space ☐ Basement w/plumbing ☑ Basement wo/plumbing

Garbage Disposal: ☑ Yes ☐ No

Auto. Dishwasher: ☑ Yes ☐ No

Auto. Washing Machine: ☑ Yes ☐ No


Other

Comments

INITIAL SITE SKETCH

100% Repair area

AS BUILT SKETCH

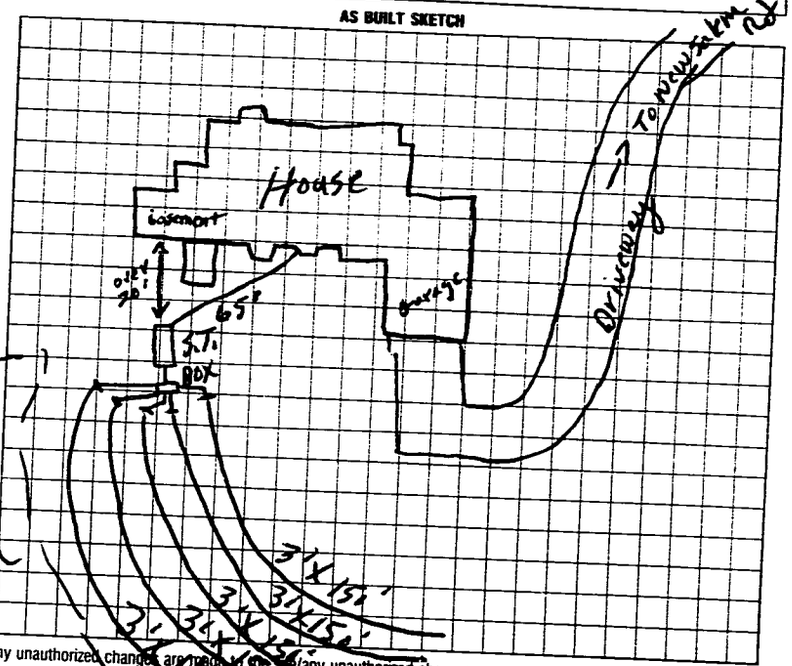

I understand that this permit can be suspended or revoked if any false information is supplied toward securing the permit/any unauthorized changes are made to the system. Improvement Permit is valid for 60 months from date of issuance. Certificate of Completion is void if any unauthorized changes are made in the installation of the system.

Signed:

Improvement Permit by: P. C. Moore date 5-27-93

Existing System Inspection by: date

Installed by: WCS Lytton

Certificate of Completion by: P.C.Moore date 9-27-93

Operation ~~Permit~~ by: date

HEALTH DEPT. COPY: WHITE INSPECTION COPY (FINAL): GREEN OWNER COPY (FINAL): YELLOW INSPECTION COPY (INITIAL): PINK OWNER COPY (INITIAL): GOLD