THIS PERMIT REPLACES PREVIOUS ISSUED 2-10-06

# IREDELL COUNTY HEALTH DEPARTMENT

STATESVILLE 704-878-5305 MOORESVILLE 704-664-5281

## IMPROVEMENT PERMIT / AUTHORIZATION TO CONSTRUCT / OPERATION PERMIT / EXISTING SYSTEM INSPECTION

PERMIT# 133553 PIN# 4775-24-0618 DATE 7-26-06

OWNER OR APPLICANT SCHUMACHER HOMES of N.C. PHONE: Business 704-746-7197 Home 704-662-3228

ADDRESS 109-H WILLIAMSON ROAD, MOORESVILLE, NC 28117

LOCATION US64 EAST, TL SAIN ROAD, 3RD LOT ON LEFT PAST WINAINE BROOK WAY

SUBDIVISION SPRING FOREST BLOCK / SECTION ____ LOT 91 LOT AREA 0.667 ACRE SITE CLASS PS DESIGN FLOW 360 L.T.A.R. 0.25 GPD/FT2

Septic Tank: 1000 Gallons; STB 1000 Date 7-25-06
Pump Tank: ____ Gallons; PT ____ Date ____
Pump Make: ____ Model ____ Serial No. ____
Nitrification Field: No Fields 1 Square Feet OR 1440 Linear Feet 360
No Lines NINE Trench Width 36" Max Trench Bottom Depth 24"

☑ New System ☐ Repair ☐ Expansion System Type: I II III IV V VI
System Description: 25% REDUCTION, GRAVITY
Repair System Description: LOW PRESSURE PDBPS
Maintenance Agreement Required: ☐ Yes ☑ No (502 RQD)

☑ House/Mod. Home No. Bedrooms 3
☐ Mobile Home No. Persons ____
☐ Business No. Employees ____
☐ Other ____


Water Supply: ☐ Individual ☑ Public ☐ Community

☑ Gravity ☐ Pressure ☐ Slab ☐ Crawl Space ☐ Basement w/plumbing ☐ Basement wo/plumbing


Comments:/Conditions: INSTALL 25% REDUCTION SYSTEM NO DEEPER THAN 24"

Comments:/Conditions: Tank Risers Septic tank Manhole Green Tanks Sales

INITIAL SITE SKETCH ~ SCALE: 1"=40'

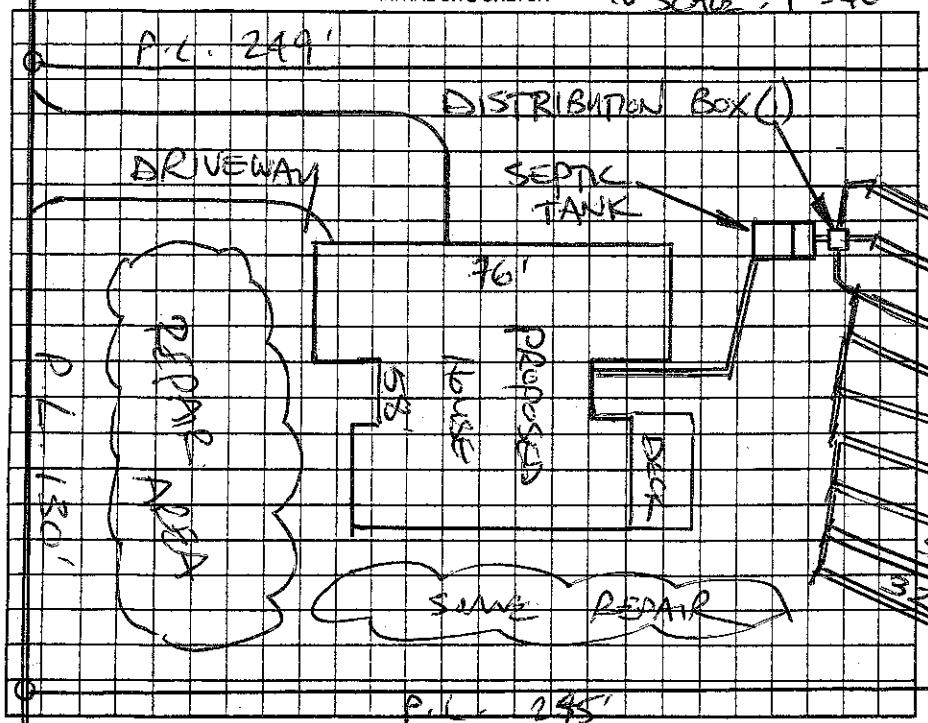


AS BUILT SKETCH

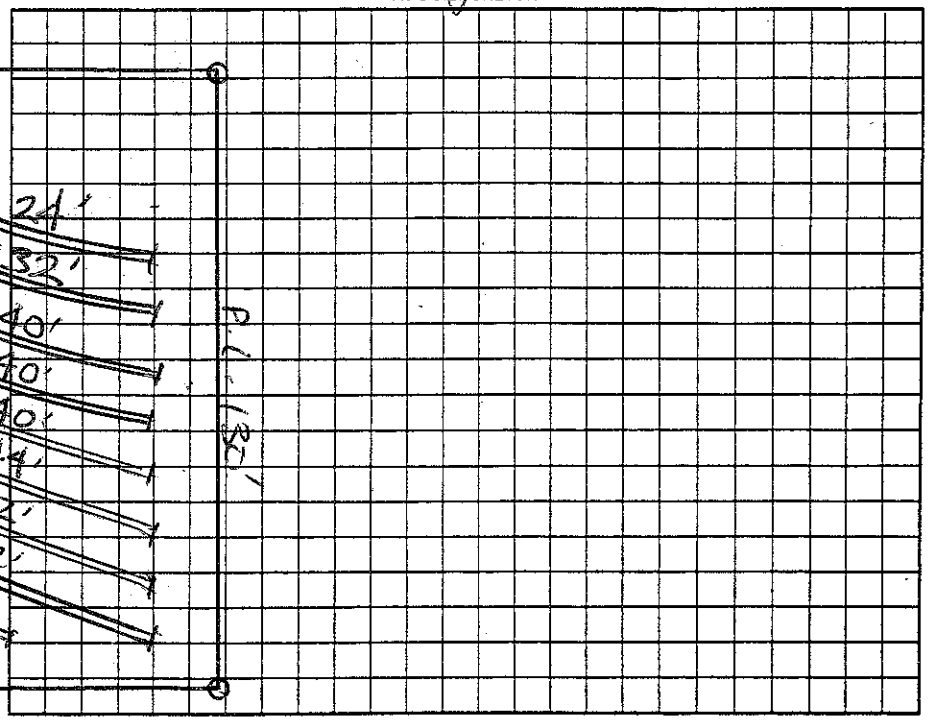


Permit can be suspended or revoked if any false information is supplied toward securing the permit/any unauthorized changes are made to the site/any unauthorized changes are made in the installation of the system. Improvement Permit with plat valid without expiration. ☐ Improvement Permit with site plan valid for sixty months ☑ Authorization to Construct is valid for a period equal to that of Improvement Permit – not to exceed sixty months.

Signed: Robin Swaney date 7/26/06 Installed by: Hoglan and Sons

Improvement Permit by: STEVE HEDRICK date 7-26-06 Operation Permit by: [signature] date 7-28-06

Authorization to Construct by: STEVE HEDRICK date 7-26-06 Existing System Inspection by: ____ date ____

HEALTH DEPT. COPY: WHITE OWNER COPY (FINAL): YELLOW OWNER COPY (INITIAL): PINK