IREDELL COUNTY HEALTH DEPARTMENT

STATESVILLE 704-878-5305 (I) MOORESVILLE 704-664-5281

IMPROVEMENT PERMIT / AUTHORIZATION TO CONSTRUCT / OPERATION PERMIT / EXISTING SYSTEM INSPECTION

PERMIT# 13268 PIN# 4775240844 DATE 2-10-06

OWNER OR CONTRACTOR Stiles, Ellis & Pope Builders PHONE: Business 704 873 7373 Home

ADDRESS 611B Sullivan RD Statesville NC 28625

LOCATION 64E. (T) Sloan 4th on left

SUBDIVISION Springfield BLOCK / SECTION LOT 8 LOT AREA .654 SITE CLASS RS DESIGN FLOW 360 L.T.A.R. .25

Septic Tank: 1000 Gallons; STB 702 Date 3-12-06
Pump Tank: Gallons; PT Date
Pump Make: Model Serial No.
Nitrification Field: No Fields Square Feet 1440 Linear Feet 360
No Lines 4 Trench Width 36" Max Trench Bottom Depth 24" Gravel Depth

☑ New System ☐ Repair System Type: I, II, III, IV, V, VI
System Description: 2502 GRAVITY
Repair System Description: LPP 2 (2) Repair
Maintenance Agreement Required: ☐ Yes ☑ No

☑ House/Mod. Home No. Bedrooms 3
☐ Mobile Home No. Bathrooms
☐ Business No. Employees
☐ Other


☐ Slab ☐ Crawl Space ☐ Basement w/plumbing ☐ Basement wo/plumbing

Water Supply: ☐ Individual ☑ Public ☐ Community

Comments:/Conditions:
Install on contour
Maintain all setbacks

Comments:/Conditions:
24" Trench Bottom
Septic Tank Marker
Yellow Buff Tile

INITIAL SITE SKETCH

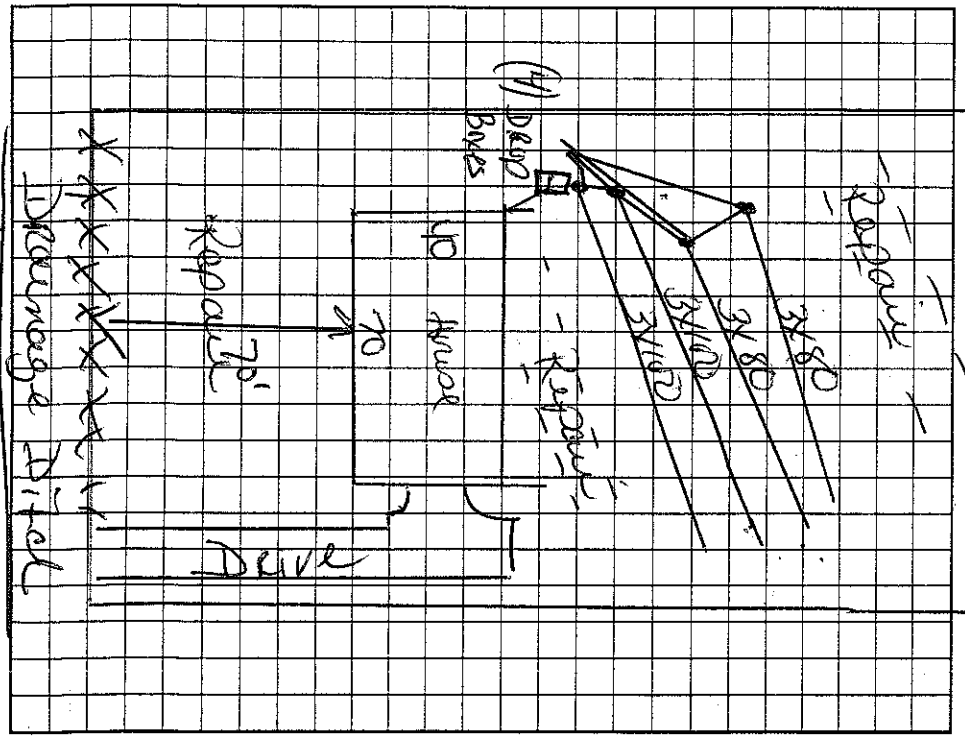

AS BUILT SKETCH

Permit can be suspended or revoked if any false information is supplied toward securing the permit/any unauthorized changes are made to the site/any unauthorized changes are made in the installation of the system. Improvement Permit with plat valid without expiration. Improvement Permit with site plan valid for sixty months. Authorization to Construct is valid for a period equal to that of Improvement Permit – not to exceed sixty months.

Signed: date 2-13-06 Installed by: DAVID Yountz

Improvement Permit by: date 2-10-06 Operation Permit by: date 9-12-06

Authorization to Construct by: date 3-9-06 Existing System Inspection by: date

HEALTH DEPT. COPY: WHITE OWNER COPY (FINAL): YELLOW OWNER COPY (INITIAL): PINK