IREDELL COUNTY HEALTH DEPARTMENT

STATESVILLE 704-878-5305 MOORESVILLE 704-664-5281

IMPROVEMENT PERMIT / AUTHORIZATION TO CONSTRUCT / OPERATION PERMIT / EXISTING SYSTEM INSPECTION

PERMIT# 132682 PIN# 4775240973 DATE 2-10-06

OWNER OR CONTRACTOR Stiles, Ellis, Pope Builders PHONE: Business 704-873-7373 Home

ADDRESS 611 B Sullivan RD Statesville, NC 28625

LOCATION Left FO Stair Lot 5th on Left

SUBDIVISION Springfield BLOCK / SECTION LOT 7 LOT AREA 6780 SITE CLASS P5 DESIGN FLOW 360 L.T.A.R. 125

Septic Tank: 1050 Gallons; STB Date 2-13-06

Pump Tank: Gallons; PT Date

Pump Make: Model Serial No.

Nitrification Field: No Fields Square Feet 1440 Linear Feet 360

No Lines 5 Trench Width 36" Max Trench Bottom Depth 24" Gravel Depth

☑ New System ☐ Repair System Type: I II III IV V VI

System Description: 25% Gravity

Repair System Description: LPP

Maintenance Agreement Required: ☐ Yes ☑ No

☑ House/Mod. Home No. Bedrooms 3

☐ Mobile Home No. Bathrooms

☐ Business No. Employees

☐ Other

☐ Slab ☑ Crawl Space ☐ Basement w/plumbing ☐ Basement wo/plumbing

Water Supply: ☐ Individual ☑ Public ☐ Community


Comments:/Conditions:

Distribution box
24" Lined Bottom

Comments:/Conditions:

Install on Contour
Maintain all setbacks

INITIAL SITE SKETCH

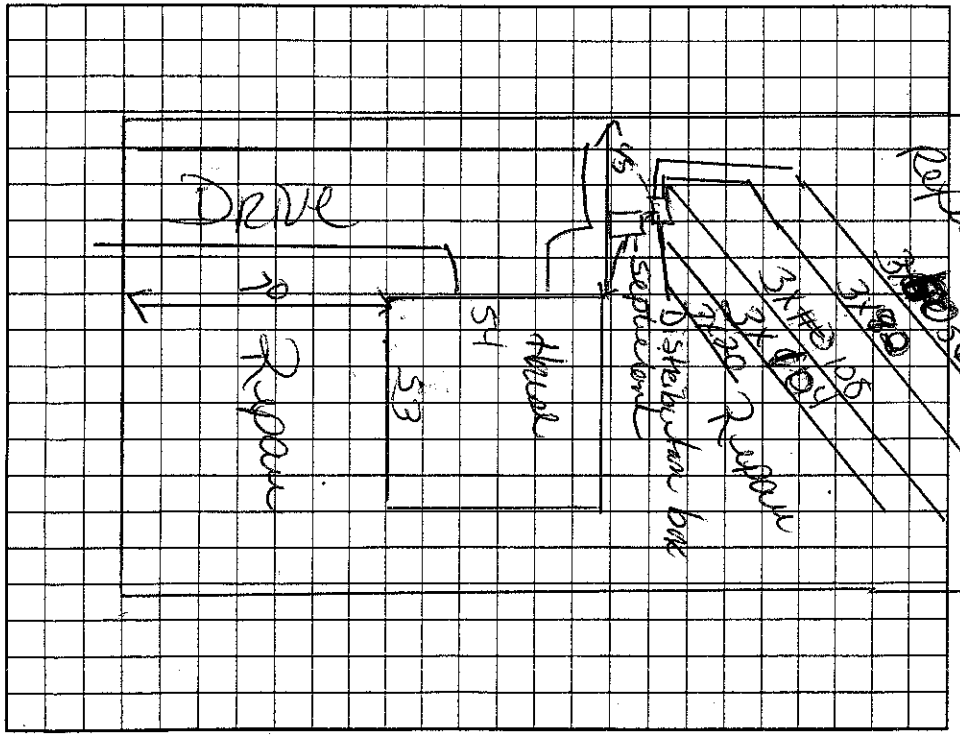

AS BUILT SKETCH

Permit can be suspended or revoked if any false information is supplied toward securing the permit/any unauthorized changes are made to the site/any unauthorized changes are made in the installation of the system. Improvement Permit with plat valid without expiration. Improvement Permit with site plan valid for sixty months. Authorization to Construct is valid for a period equal to that of Improvement Permit – not to exceed sixty months.

Signed: date 2-13-06 Installed by: DAVID YOUNTZ

Improvement Permit by: date 2-10-06 Operation Permit by: date 7-24-06

Authorization to Construct by: date 2-10-06 Existing System Inspection by: date

HEALTH DEPT. COPY: WHITE OWNER COPY (FINAL): YELLOW OWNER COPY (INITIAL): PINK