IREDELL COUNTY HEALTH DEPARTMENT

THIS PERMIT VOIDS PREVIOUS ISSUED 2-23-04

STATESVILLE 704-878-5305 @ MOORESVILLE 704-664-5281

IMPROVEMENT PERMIT / AUTHORIZATION TO CONSTRUCT / OPERATION PERMIT / EXISTING SYSTEM INSPECTION

PERMIT# 118063 PIN# 4775-24-2361 DATE 1-19-06

OWNER OR CONTRACTOR GARY SWAENEPOEL PHONE: Business 336-751-6857 Home 704-838-1610/528-3292

ADDRESS 1332 TRIPLETT RD CLEVELAND, NC 27013

LOCATION US 64 E, TL SAIN ROAD, 1ST TRACT ON RIGHT

SUBDIVISION _____ BLOCK / SECTION _____ LOT _____ LOT AREA 5.286 ACRES SITE CLASS. PS DESIGN FLOW 360 L.T.A.R. 0.20 GPD/FT²

Septic Tank: 1000 Gallons; STB 312 Date 2-16-06
Pump Tank: 1000 Gallons; PT 27 Date 3-7-06
Pump Make: ZOELLER Model N16 2 Serial No. _____
Nitrification Field: No Fields 1 Square Feet 1800 Linear Feet 600
No Lines FOUR Trench Width 36" Max Trench Bottom Depth 36" Gravel Depth 12"

☑ New System ☐ Repair System Type: I, II, (III), IV, V, VI
System Description: CONVENTIONAL PUMP
Repair System Description: 50% REDUCTION LOW-PRESSURE
Maintenance Agreement Required: ☐ Yes ☑ No


☑ House/Mod. Home No. Bedrooms 3
☐ Mobile Home No. Bathrooms ____
☐ Business No. Employees ____
☐ Other ____
☐ Slab ☑ Crawl Space ☐ Basement w/plumbing ☐ Basement wo/plumbing

Water Supply: ☐ Individual ☑ Public ☐ Community


Comments:/Conditions: ① SCOUR TRENCH SIDEWALLS & APPLY A LIGHT DUSTING of LIME ② SEE ATTACHED SHEETS FOR PUMP AND PRESSURE MANIFOLD REQUIREMENTS ③ AN "ACCEPTED" SYSTEM MAY ALSO BE USED.

Comments:/Conditions: SEPTIC TANK WITH MARKER INSTALLED USING RED "POLYLOK" FILTER

INITIAL SITE SKETCH

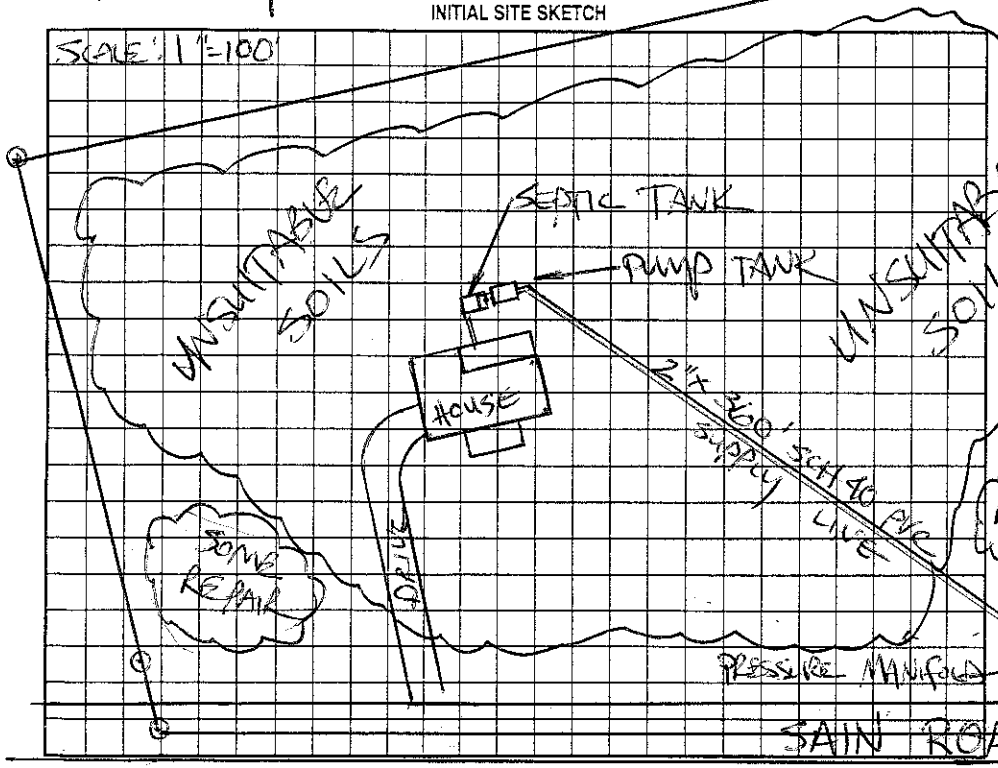

AS BUILT SKETCH

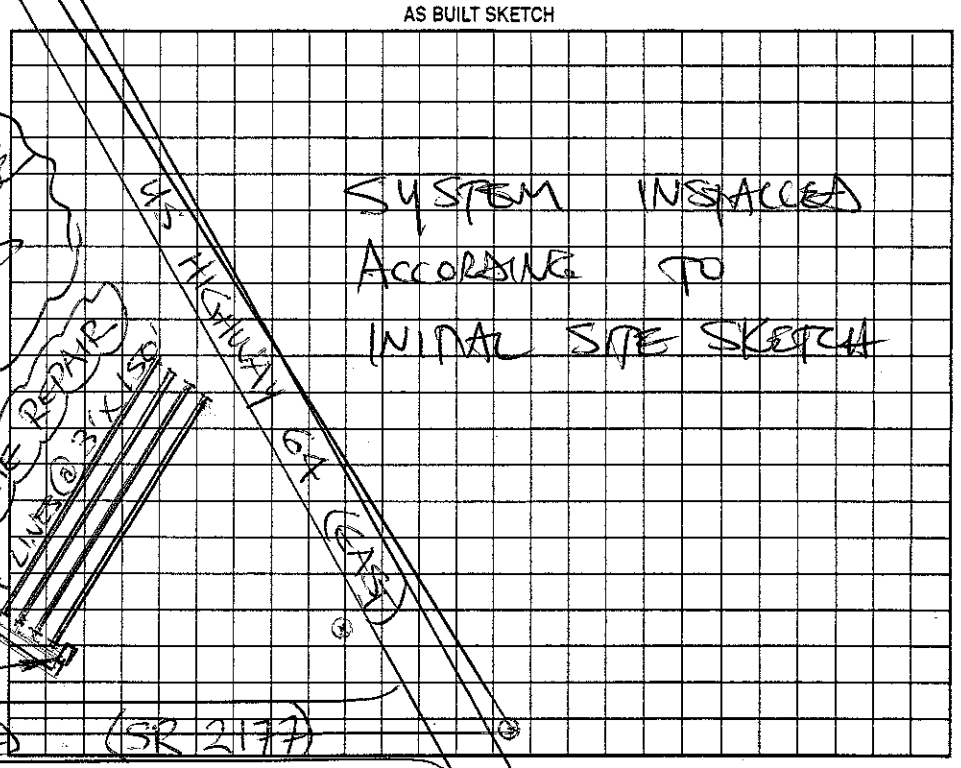

Permit can be suspended or revoked if any false information is supplied toward securing the permit/any unauthorized changes are made to the site/any unauthorized changes are made in the installation of the system. Improvement Permit with plat valid without expiration. Improvement Permit with site plan valid for sixty months. Authorization to Construct is valid for a period equal to that of Improvement Permit – not to exceed sixty months.

Signed: _____ date 2-3-06 Installed by: SPECIALTY SEPTIC

Improvement Permit by: STEVE HEDRICK date 1-19-06 Operation Permit by: STEVE HEDRICK date 5-3-06

Authorization to Construct by: STEVE HEDRICK date 1-19-06 Existing System Inspection by: _____ date _____

HEALTH DEPT. COPY: WHITE OWNER COPY (FINAL): YELLOW OWNER COPY (INITIAL): PINK