IREDELL COUNTY HEALTH DEPARTMENT

CI / CI

STATESVILLE 704-878-5305 MOORESVILLE 704-664-5281

IMPROVEMENT PERMIT / AUTHORIZATION TO CONSTRUCT / OPERATION PERMIT / EXISTING SYSTEM INSPECTION

PERMIT# 108590 PIN# 4775-25-1361 DATE 09-19-02

OWNER OR CONTRACTOR TODD ELLIS PHONE: Business Home 704-878-6633

ADDRESS 315 7 SPRINGS COOP STATESVILLE, NC 28677

LOCATION 64 EAST, (L) SAIM RD, LOT #4 ON LEFT

SUBDIVISION SPRING FOREST BLOCK / SECTION LOT 4 LOT AREA .7384 AC SITE CLASS. PS DESIGN FLOW 360 L.T.A.R. .3

Septic Tank: 1000 Gallons; STB 1017 Date 9-3-02

Pump Tank: Gallons; PT Date

Pump Make: Model Serial No.

Nitrification Field: No Fields 1 Square Feet 1200' Linear Feet 400'

No Lines 4X100' Trench Width 36" Max Trench Bottom Depth 36" Gravel Depth 12"

[X] New System [ ] Repair System Type: I (II) III. IV. V. VI

System Description: CONV GRAV

Repair System Description: SHALLOW 25% REDUCT

Maintenance Agreement Required: [ ] Yes [X] No

[X] House/Mod. Home No. Bedrooms 3

[ ] Mobile Home No. Bathrooms 2

[ ] Business No. Employees


[ ] Other

[ ] Slab [X] Crawl Space [ ] Basement w/plumbing [ ] Basement wo/plumbing


Water Supply: [ ] Individual [X] Public [ ] Community

Comments:/Conditions: (1) LESS THAN 2% SLOPE. LINES DO NOT NEED TO FOLLOW CONTOUR (2) USE DIST. BOX WITH SPEED LEVELERS. (3) MAINTAIN SETBACKS; H2O LINE 10' FROM SYSTEM. (4) SUPPLY LINE CAN BE 5' OFF PROPERTY LINE (5) MAKE SURE ALL LINES (FEEDING) WILL BACK UP TO BOX. TUFF TITE FITTER & MARKER

1"=50' INITIAL SITE SKETCH

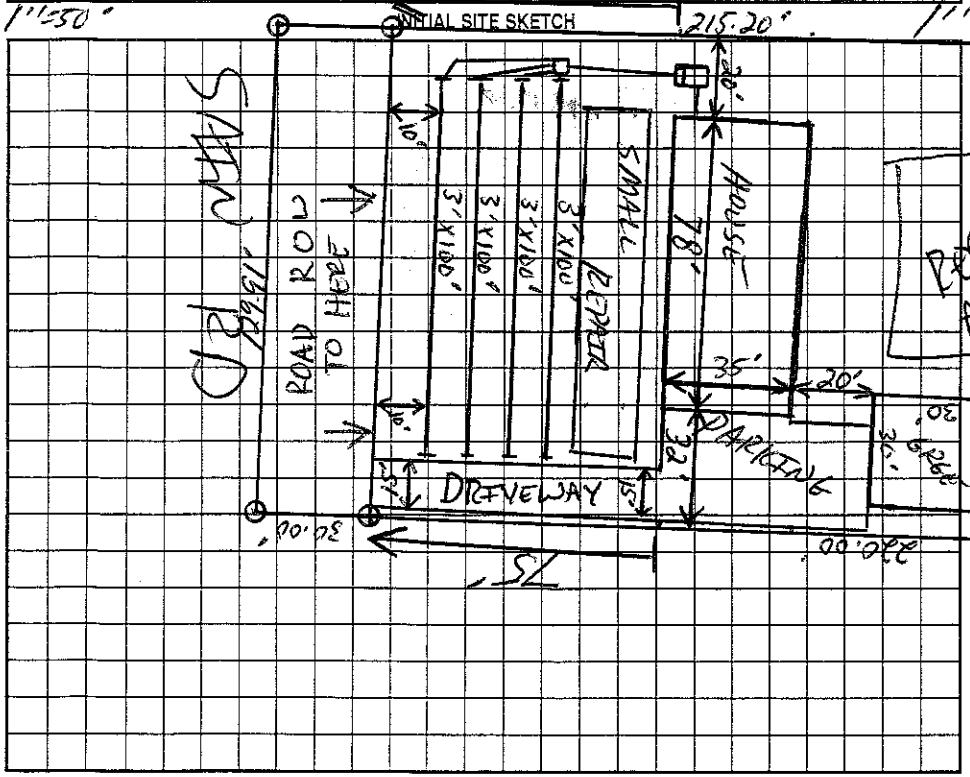

1"=50' AS BUILT SKETCH

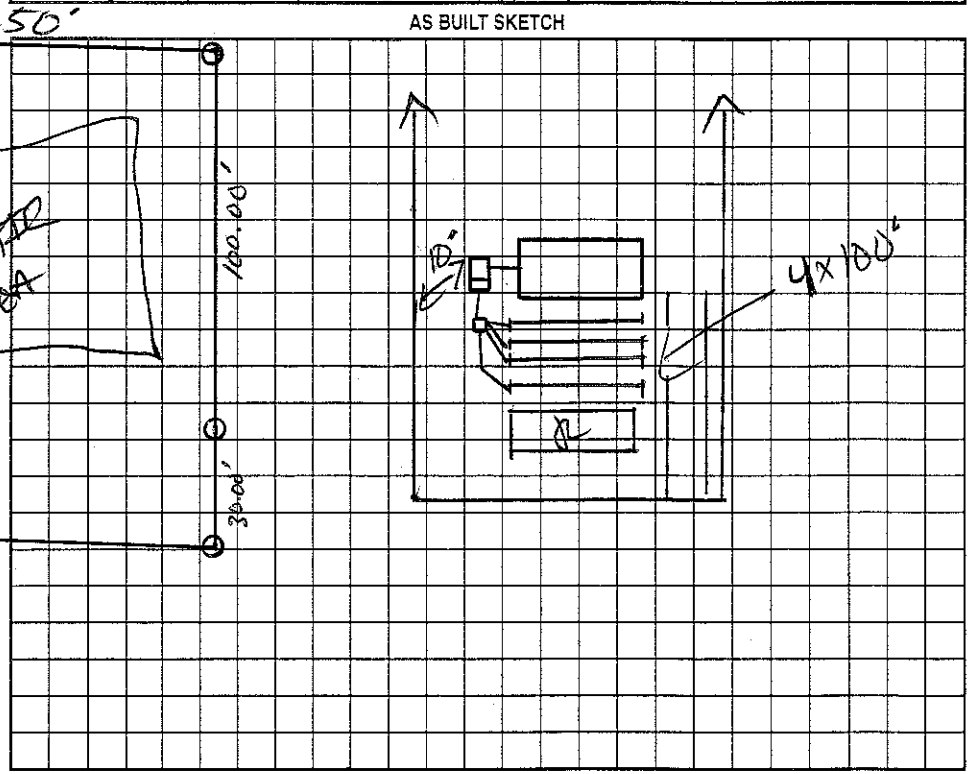

Permit can be suspended or revoked if any false information is supplied toward securing the permit/any unauthorized changes are made to the site/any unauthorized changes are made in the installation of the system. Improvement Permit with plat valid without expiration. Improvement Permit with site plan valid for sixty months. Authorization to Construct is valid for a period equal to that of Improvement Permit – not to exceed sixty months.

Signed: date 9-19-02 Installed by: DAVID YOUNTZ

Improvement Permit by: RS date 9-19-02 Operation Permit by: RS date 05-01-03

Authorization to Construct by: RS date 9-19-02 Existing System Inspection by: date

HEALTH DEPT. COPY: WHITE OWNER COPY (FINAL): YELLOW OWNER COPY (INITIAL): PINK