IREDELL COUNTY HEALTH DEPARTMENT

Statesville Office (704) 878-5305 Mooresville Office (704) 660-3625 PERMIT # 208016

IMPROVEMENT PERMIT / AUTHORIZATION TO CONSTRUCT / OPERATION PERMIT / EXISTING SYSTEM

PIN # 4775 25 1361

APPLICANT: Larry Munday APPLICANT ADDRESS: 673 Shiloh Rd Statesville NC

SITE ADDRESS: 169 Sain Rd Statesville NC 28625 PHONE: 704-902-1479 ALT. PHONE: 704-682-5599


SITE DIRECTIONS: 64E T/R onto Sain Rd house on left

SUBDIVISION: Spring Forest SECTION: N/A LOT # 4 LOT AREA: .7384 ac DESIGN FLOW: 360 L.T.A.R.: Ex


Septic Tank	Ex	(gal)	STB		Date		☐ New System	☐ Repair	☐ Expansion	System Type: I II III IV V VI	☒ Residence	No. Bedrooms	3	Water Supply	
Pump Tank		(gal)	PT		Date		System Description:	Existing			☐ Business	No. Persons	6	☒ Private	
Pump Make		Model			Serial #		Repair System Description:				☐ Other	No. Employees		☐ Public	
# Nitrification Fields	Ex	# Lines	Ex		Linear Ft:	Ex	Maintenance Agreement Required:	☐ YES	☒ NO		☐ Slab	☒ Crawl Space		☐ Community	
Trench Width	Ex	Max. Trench Bottom Depth		Ex	Gravel Depth	Ex		☐ GRAVITY	☐ PRESSURE		☐ Basement w/plumbing		☐ Basement w/o plumbing		

Comments / Conditions: All building foundations must be 55' from any part of STS.

INITIAL SITE SKETCH

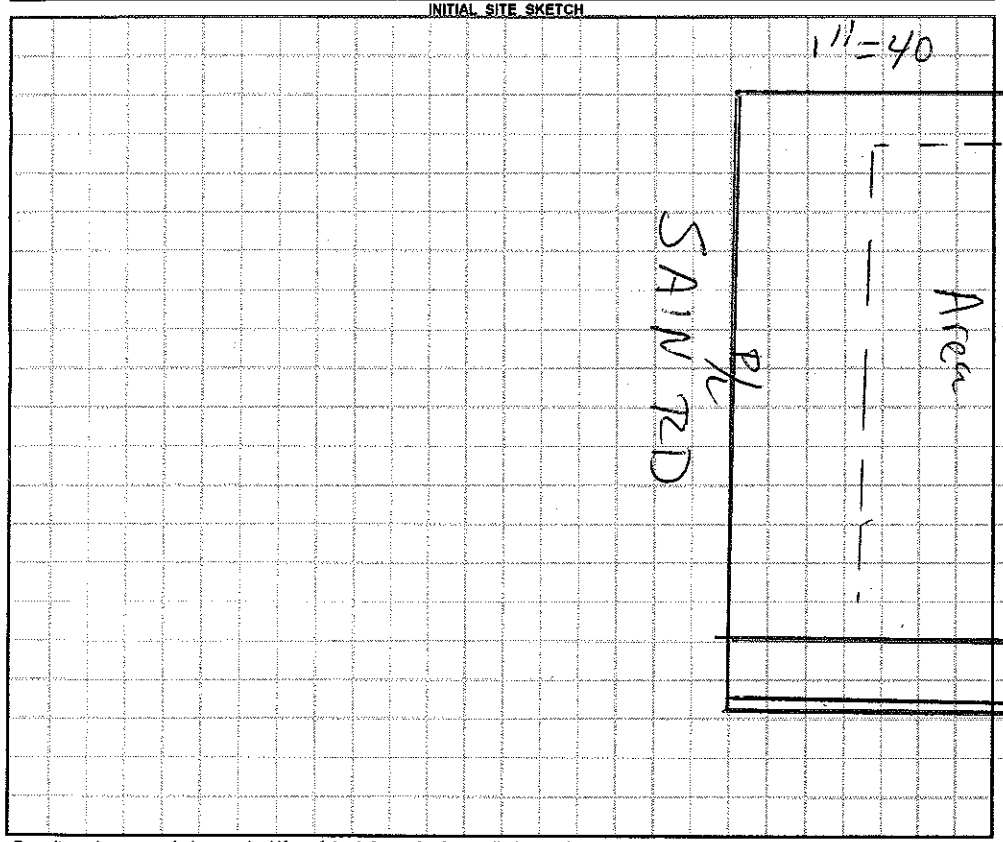

AS BUILT SKETCH

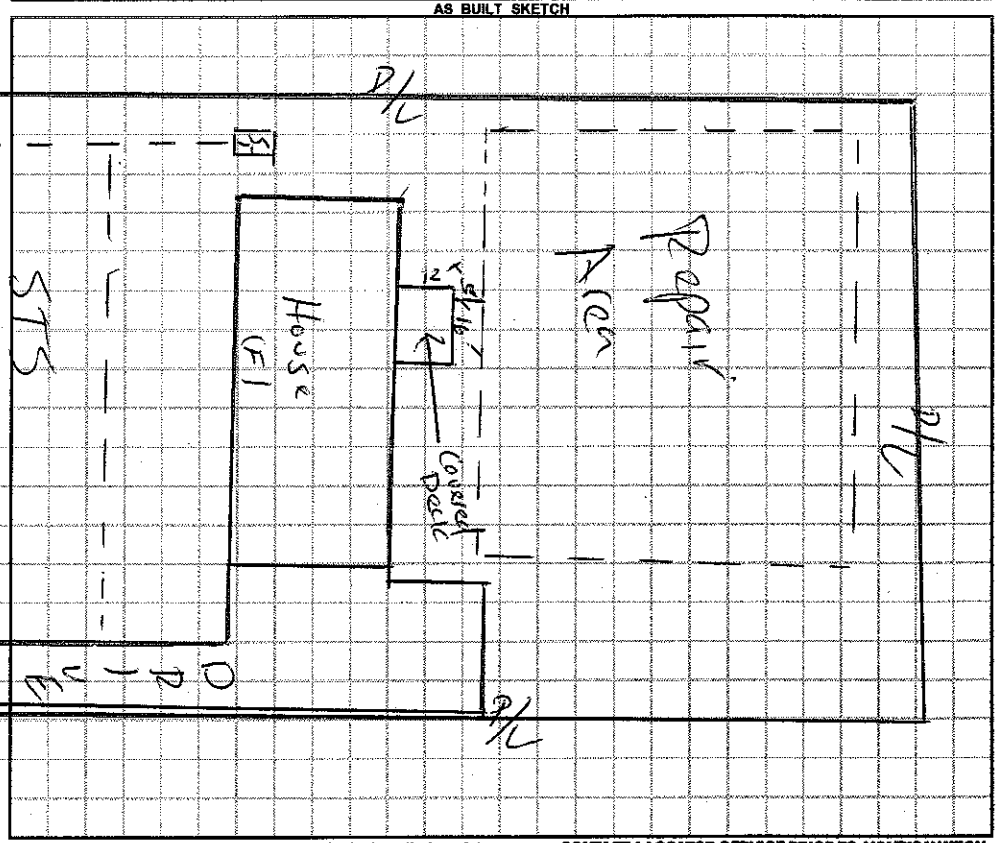

Permit can be suspended or revoked if any false information is supplied toward securing the permit / any unauthorized changes are made to the site / any unauthorized changes are made in the installation of the system. **CONTACT A LOCATOR SERVICE PRIOR TO ANY EXCAVATION**

☐ **IMPROVEMENT PERMIT** *with plat valid without expiration.* ☐ **IMPROVEMENT PERMIT** *with site plan valid for 60 mos.* ☐ **AUTHORIZATION TO CONSTRUCT** *valid for period equal to IMPROVEMENT PERMIT--not to exceed 60 mo.*

Owner / Applicant Signature: Larry Munday Date: 2-2-15 Installed by:

IMPROVEMENT PERMIT by: Date: OPERATION PERMIT by: Date:

AUTHORIZATION TO CONSTRUCT by: Date: Existing System Inspected by: Date: 02/02/15

Health Dept. Copy - WHITE Applicant (Final Approval) - YELLOW Applicant (Conditional Approval) - PINK