IREDELL COUNTY HEALTH DEPARTMENT

STATESVILLE 704-878-5305 MOORESVILLE 704-664-5281

IMPROVEMENT PERMIT / CERTIFICATE OF COMPLETION / OPERATION PERMIT / EXISTING SYSTEM INSPECTION

PROPERTY DESCRIPTION NO. 68953 DATE 8-30-97 TAX MAP NO. 4775 25 6878

OWNER OR CONTRACTOR Randy E. Foster PHONE: Business _____ Home 871 1959

ADDRESS 744 Bailey Pl Statesville Watershed: ☐ Yes ☐ No

LOCATION 64E Th Sain Rd on Rt corner Salem loop (206 Sain Rd)

SUBDIVISION Salem Pk BLOCK / SECTION _____ LOT 23+24 LOT AREA 1.53 acres SITE CLASS. PS DESIGN FLOW 360 L.T.A.R. .3

Septic Tank: 1000 Gallons; STB 1012 Date 11-15-97

Pump Tank: _____ Gallons; PT _____ Date _____

Pump Make: _____ Model _____ Serial No. _____

Nitrification Field: No Fields 1 Square Feet 1200 Linear Feet 400

No Lines 3 Trench Width 36" Max Trench Bottom Depth 36" Gravel Depth 12"

☒ New System ☐ Repair System Type: I, II, III, IV, V, VI

System Description: Conv. Gravity

Repair System Description: " "

Maintenance Agreement Required: ☐ Yes ☒ No

☒ House/Mod. Home No. Bedrooms 3

☐ Mobile Home No. Bathrooms 2

☐ Business No. Employees ____

☐ Other _____


☐ Slab ☒ Crawl Space ☐ Basement w/plumbing ☐ Basement wo/plumbing

Water Supply: ☐ Individual ☐ Community ☒ Public


Comments: Salem Loop 1501

Comments:

INITIAL SITE SKETCH

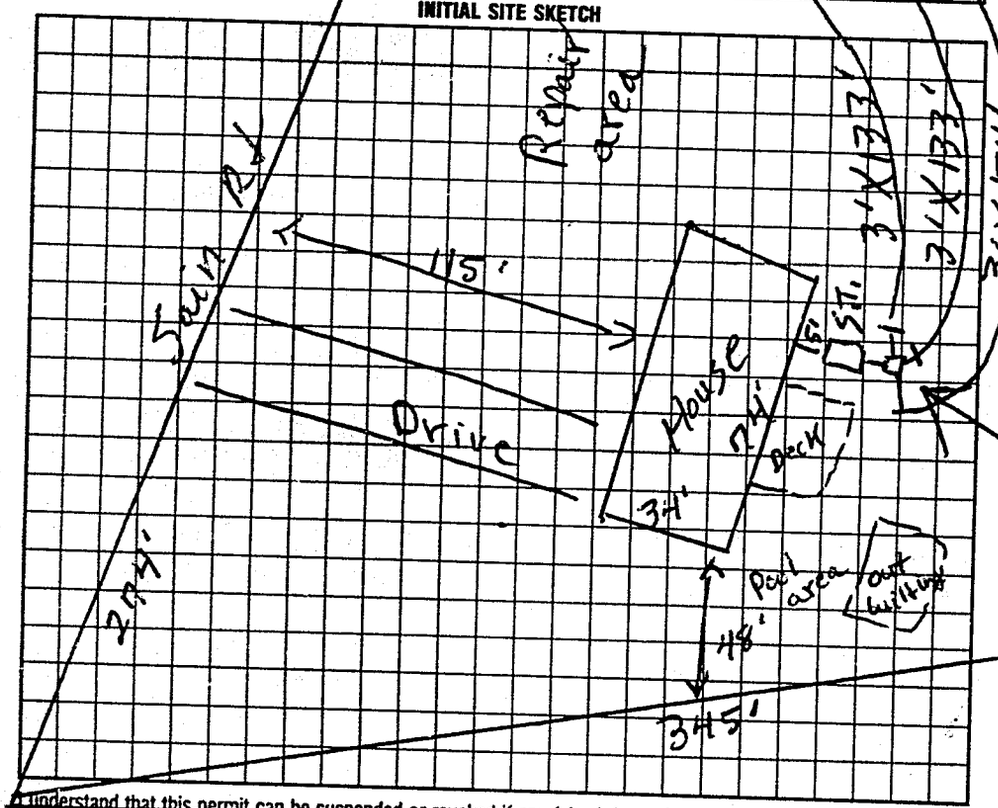

AS BUILT SKETCH

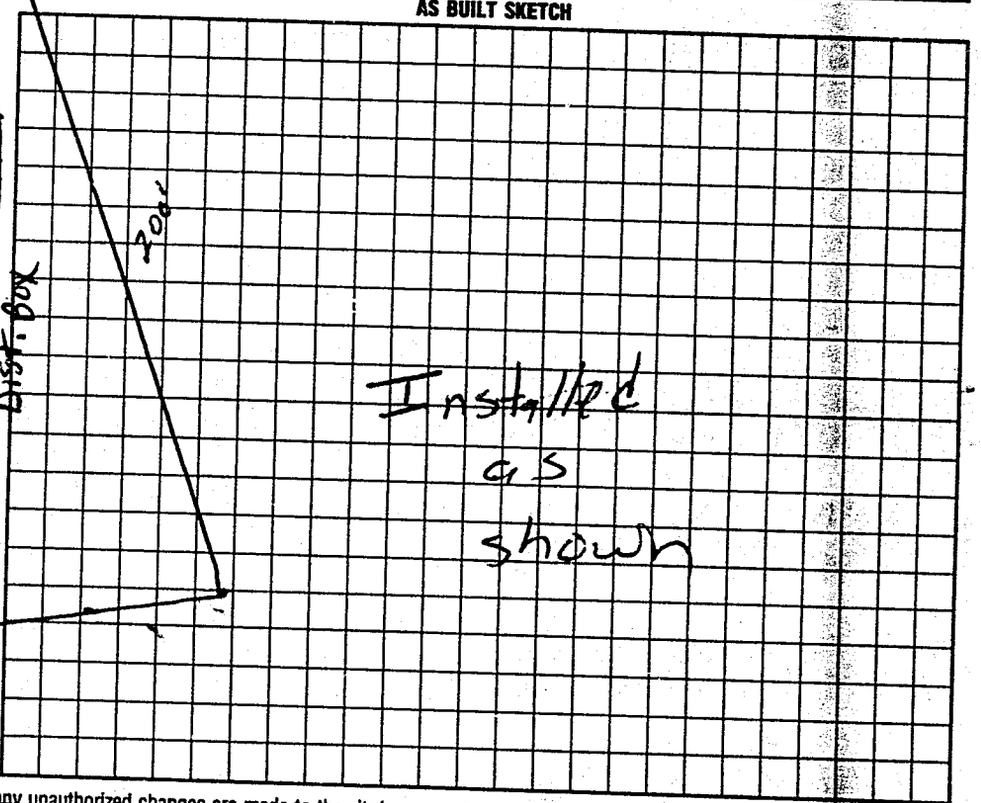

I understand that this permit can be suspended or revoked if any false information is supplied toward securing the permit/any unauthorized changes are made to the site/any unauthorized changes are made in the installation of the system. Improvement Permit is valid for 60 months from date of issuance.

Signed: Randy E. Foster

Improvement Permit by: P.C. Moore date 8-30-97

Existing System Inspection by: P.C. Moore date 8-30-97

Installed by: A-1 Backhoe

Certificate of Completion by: _____ date _____

Operation Permit by: Mary C Ott RS date 2-20-98

Authorization to count Expires 60 mos from issue

to count.

HEALTH DEPT COPY: WHITE INSPECTION COPY (FINAL): GREEN OWNER COPY (FINAL): YELLOW INSPECTION COPY (INITIAL): PINK OWNER COPY (INITIAL): GOLD