IREDELL COUNTY HEALTH DEPARTMENT

STATESVILLE 704-878-5305 MOORESVILLE 704-664-5281

IMPROVEMENT PERMIT / AUTHORIZATION TO CONSTRUCT / OPERATION PERMIT / EXISTING SYSTEM INSPECTION

PERMIT# 117944 PIN# 4775-26-4829-2 4883 DATE 2-12-04

OWNER OR CONTRACTOR RONALD & ANN CAMPBELL PHONE: Business Home 704-871-8906

ADDRESS 309 ST. ANDREWS RD, STATESVILLE, NC 28625

LOCATION US 64 EAST, TL SAIN ROAD, TL DEWBERRY LANE, LOT AT END ON LEFT

SUBDIVISION RON CAMPBELL BLOCK / SECTION LOT 2 LOT AREA 3.04 ± Acres SITE CLASS. PS DESIGN FLOW 360 L.T.A.R. 0.25 GPD/FT2

Septic Tank: 1000 Gallons; STB 1012 Date 3-26-04
Pump Tank: Gallons; PT Date
Pump Make: Model Serial No.
Nitrification Field: No Fields 1 Square Feet EQ.P 1440 Linear Feet 360
No Lines FIVE Trench Width 36" Max Trench Bottom Depth 36" Gravel Depth N/A

☑ New System ☐ Repair System Type: I, II, (III), IV, V, VI
System Description: 25% REDUCTION, GRAVITY
Repair System Description: 25% REDUCTION, PUMP
Maintenance Agreement Required: ☐ Yes ☑ No


☑ House/Mod. Home No. Bedrooms 3
☐ Mobile Home No. Bathrooms 2½
☐ Business No. Employees
☐ Other
☐ Slab ☑ Crawl Space ☐ Basement w/plumbing ☐ Basement wo/plumbing

Water Supply: ☑ Individual ☐ Public ☐ Community WELL


Comments:/Conditions: ① INSTALL 25% REDUCTION SYSTEM USING CHAMBERS W/ CONTOUR PANELS OR EEE-ZZZ-FLOW.
② KEEP SYSTEM MINIMUM 100' FROM WELL.

Comments:/Conditions: SYSTEM ALTERED AS SHOWN WITH PRIOR HEALTH DEPT. APPROVAL, SEPTIC TANK WITH MARKER INSTALLED USING "THRIFTITE" FILTER

INITIAL SITE SKETCH

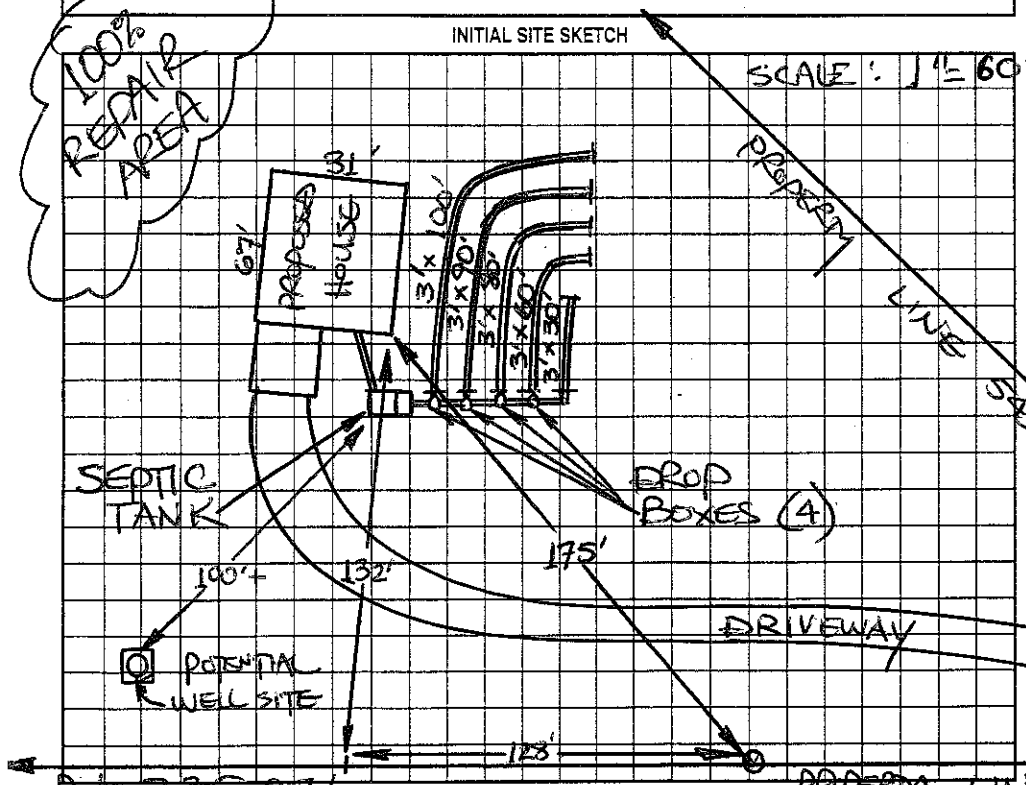

AS BUILT SKETCH

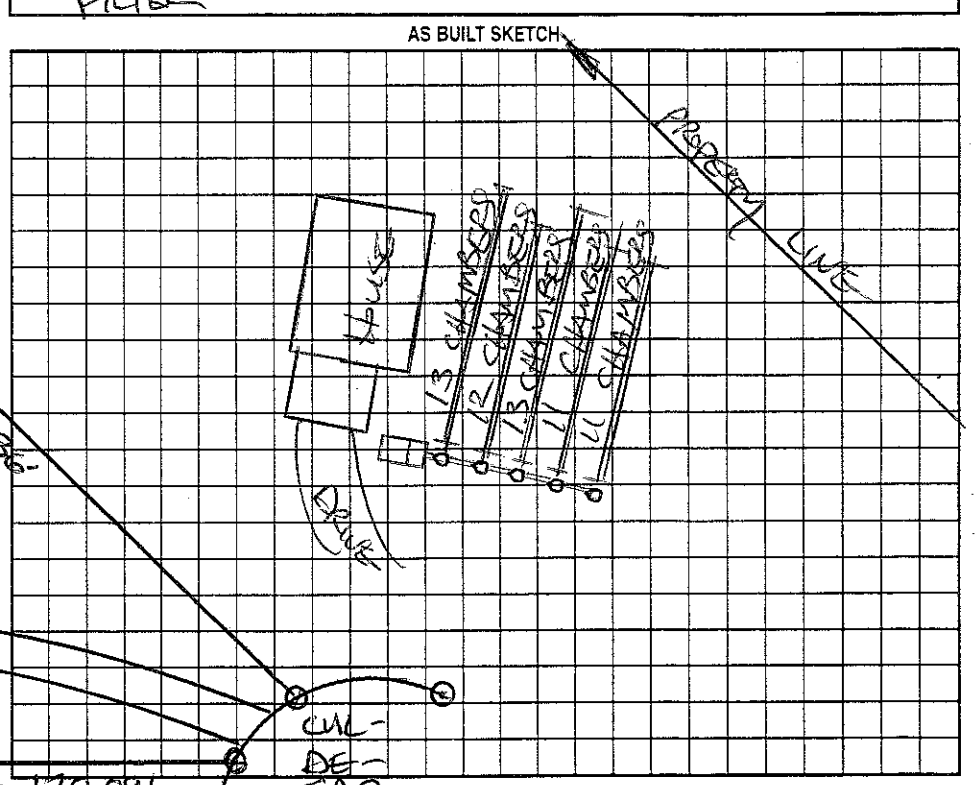

Permit can be suspended or revoked if any false information is supplied toward securing the permit/any unauthorized changes are made to the site/any unauthorized changes are made in the installation of the system. Improvement Permit with plat valid without expiration. Improvement Permit with site plan valid for sixty months. Authorization to Construct is valid for a period equal to that of Improvement Permit – not to exceed sixty months.

Signed: Ron Campbell date 2-15-04
Improvement Permit by: STEVE HEDRICK date 2-12-04
Authorization to Construct by: STEVE HEDRICK date 2-12-04

Installed by: TOMMY FRYE
Operation Permit by: STEVE HEDRICK date 8-18-04
Existing System Inspection by: date

HEALTH DEPT. COPY: WHITE OWNER COPY (FINAL): YELLOW OWNER COPY (INITIAL): PINK