IREDELL COUNTY HEALTH DEPARTMENT

STATESVILLE 704-878-5305 MOORESVILLE 704-664-5281

IMPROVEMENT PERMIT / CERTIFICATE OF COMPLETION / OPERATION PERMIT / EXISTING SYSTEM INSPECTION

PROPERTY DESCRIPTION NO. 066515 DATE 5-23-97 TAX MAP NO. 4775946664 Watershed: ☐ Yes ☑ No

OWNER OR CONTRACTOR Johns Welding Inc. PHONE: Business 873 7885 Home

ADDRESS 1516 Mocksville Hwy Sta.

LOCATION Hwy 64 E TL Hunters Ridge Sub. 2nd lot 1 left.

SUBDIVISION Hunters Ridge BLOCK / SECTION LOT 2 LOT AREA 1.5 acres SITE CLASS. PS DESIGN FLOW 360 L.T.A.R. .3

Septic Tank: 1000 Gallons; STB 1012 Date 3-17-98

Pump Tank: Gallons; PT Date

Pump Make: Model Serial No.

Nitrification Field: No Fields 1 Square Feet 1200 Linear Feet 400

No Lines 4 Trench Width 36" Max Trench Bottom Depth 36" Gravel Depth 12"

☑ New System ☐ Repair System Type: I, II, III, IV, V, VI

System Description: Conv. Gravity

Repair System Description: Pump to Chambers

Maintenance Agreement Required: ☐ Yes ☑ No

☑ House/Mod. Home No. Bedrooms 3

☐ Mobile Home No. Bathrooms 2½

☐ Business No. Employees

☐ Other


☐ Slab ☑ Crawl Space ☐ Basement w/plumbing ☐ Basement wo/plumbing

Water Supply: ☐ Individual ☐ Community ☑ Public

Comments:

Comments:

INITIAL SITE SKETCH

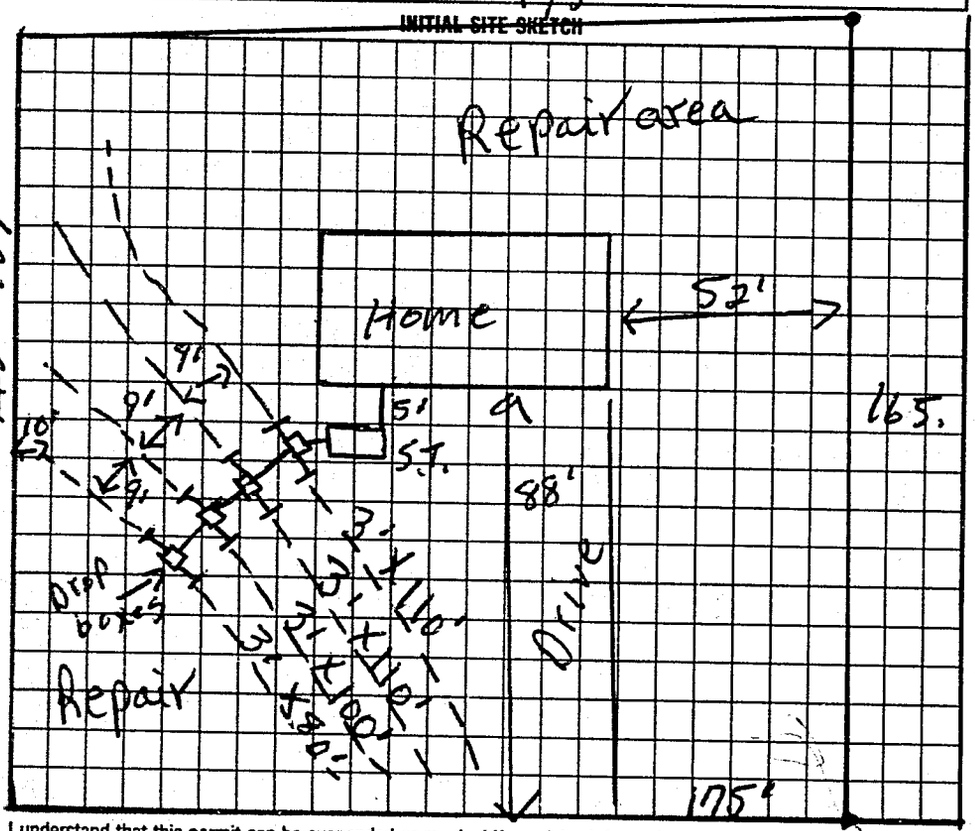

AS BUILT SKETCH

Installed as shown

I understand that this permit can be suspended or revoked if any false information is supplied toward securing the permit/any unauthorized changes are made to the site/any unauthorized changes are made in the installation of the system. Improvement Permit is valid for 60 months from date of issuance.

Signed: Mary Moorefield

Improvement Permit by: L. C. Moore date 5-23-97

Existing System Inspection by: L. C. Moore date 5-23-97

Authorization to court.

Installed by: Steve Jolly

Certificate of Completion by: date

Operation Permit by: date 5-19-98

HEALTH DEPT. COPY (WHITE) INSPECTION COPY (FINAL): GREEN OWNER COPY (FINAL): YELLOW INSPECTION COPY (INITIAL): PINK OWNER COPY (INITIAL): GOLD

Authorization to court Expires 60 mos from issue

2222208