63863

IREDELL COUNTY HEALTH DEPARTMENT

STATESVILLE 704-878-5305 MOORESVILLE 704-664-5281

IMPROVEMENT PERMIT / CERTIFICATE OF COMPLETION / OPERATION PERMIT / EXISTING SYSTEM INSPECTION

PROPERTY DESCRIPTION NO. 25398 DATE 10-31-96 TAX MAP NO. 11C-3 Watershed: ☐ Yes ☒ No

OWNER OR CONTRACTOR John's welding Inc. PHONE: Business 873-0385 Home

ADDRESS 1516 mocksville Hwy Statesville N.C.

LOCATION Hwy 64 E TL Hunters Ridge 4th lot / left

SUBDIVISION Hunters ridge BLOCK / SECTION LOT 3 LOT AREA 165 x 171 SITE CLASS. 05 DESIGN FLOW 360 L.T.A.R. 1.3 gal/sq ft/day

Septic Tank: 1000 Gallons, STB 1012 Date 1-1097
Pump Tank: Gallons; PT Date
Pump Make: Model Serial No.
Nitrification Field: No Fields 1 Square Feet 1200 Linear Feet 400
No Lines 3 Trench Width 36" Max Trench Bottom Depth 36" Gravel Depth 12"

☒ New System ☐ Repair System Type: I, II, III, IV, V, VI
System Description: Conv. Gravity
Repair System Description: Chambers
Maintenance Agreement Required: ☐ Yes ☐ No


☒ House/Mod. Home No. Bedrooms 3
☐ Mobile Home No. Bathrooms 2
☐ Business No. Employees
☐ Other
☐ Slab ☒ Crawl Space ☐ Basement w/plumbing ☐ Basement wo/plumbing

Water Supply: ☐ Individual ☐ Community ☒ Public

Comments:


171' pitlot

INITIAL SITE SKETCH

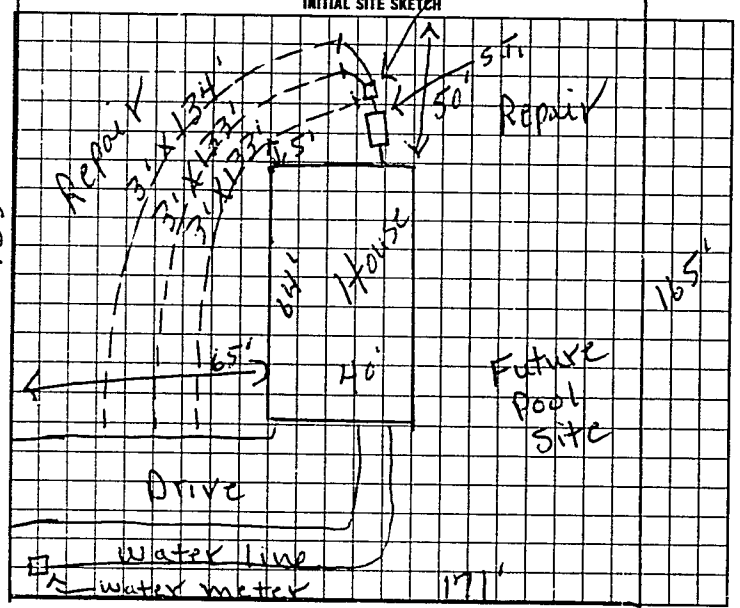

Comments:

AS BUILT SKETCH

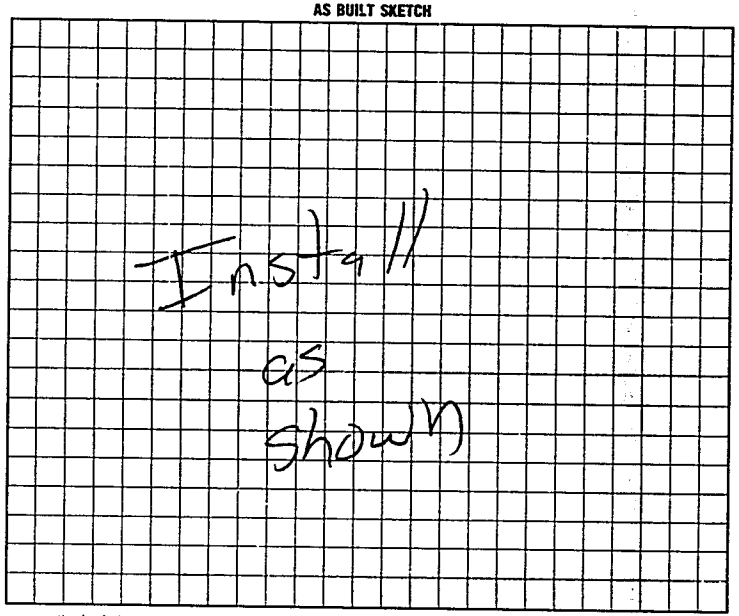

I understand that this permit can be suspended or revoked if any false information is supplied toward securing the permit/any unauthorized changes are made to the site/any unauthorized changes are made in the installation of the system.

Signed John Moore Jr

Improvement Permit by: L.C. moore date 10-31-96

Existing System Inspection Authorization to Cover: L.C. moore date 10-31-96

Installed by: A-1 Backhoe

Certificate of Completion by: date

Operation Permit by Mark Cantrell date 3-27-97

Authorization to cover Expires 60 days from issue

HEALTH DEPT. COPY: WHITE INSPECTION COPY (FINAL): GREEN OWNER COPY (FINAL): YELLOW INSPECTION COPY (INITIAL): PINK OWNER COPY (INITIAL): GOLD

2011 00