4:30 Dennis Gaither 60694

IREDELL COUNTY HEALTH DEPARTMENT

STATESVILLE 704-878-5305 MOORESVILLE 704-664-5281

IMPROVEMENT PERMIT / CERTIFICATE OF COMPLETION / OPERATION PERMIT / EXISTING SYSTEM INSPECTION

PROPERTY DESCRIPTION NO. 23676 DATE 5-11-96 TAX MAP NO. [redacted] 11C-3-9-4 Watershed: ☐ Yes ☐ No

OWNER OR CONTRACTOR John Moorefield PHONE: Business Home 873-4885

ADDRESS 1516 Mocksville Hwy Statesville

LOCATION 64E TL Hunters Ridge Lane Next to Last lot left

SUBDIVISION Hunters Ridge BLOCK / SECTION LOT 4 LOT AREA SITE CLASS. PS DESIGN FLOW 360 L.T.A.R. .3

Septic Tank: 1000 Gallons; STB [illegible] Date 5/29/96

Pump Tank: Gallons; PT Date

Pump Make: Model Serial No.

Nitrification Field: No Fields 1 Square Feet 1200 Linear Feet 400

No Lines 4 Trench Width 36" Max Trench Bottom Depth 36" Gravel Depth 12"

☑ New System ☐ Repair System Type: I, II, III, IV, V, VI

System Description: Conv. Gravity

Repair System Description: Pump To Chambers

Maintenance Agreement Required: ☐ Yes ☐ No

☑ House/Mod. Home No. Bedrooms 3

☐ Mobile Home No. Bathrooms 2

☐ Business No. Employees

☐ Other


☐ Slab ☑ Crawl Space ☐ Basement w/plumbing ☐ Basement wo/plumbing

Water Supply: ☐ Individual ☐ Community ☑ Public

Comments:


~~185'~~ 165'

INITIAL SITE SKETCH

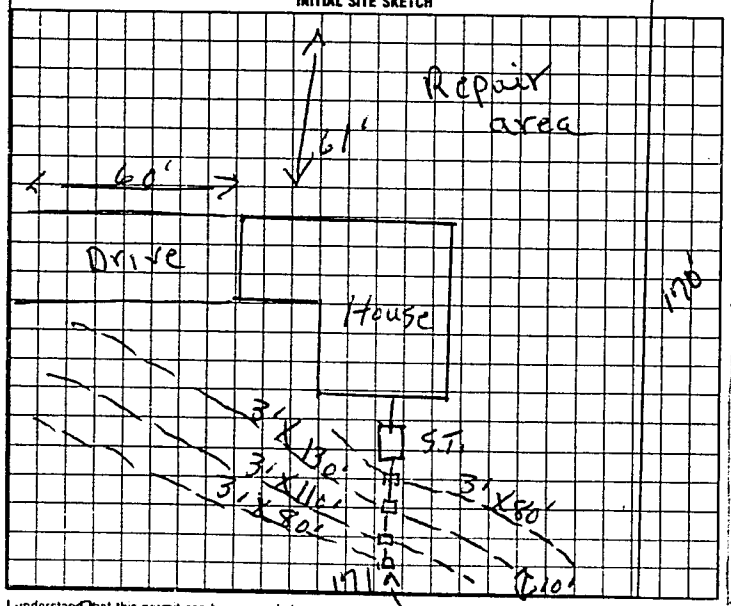

Comments:

AS BUILT SKETCH

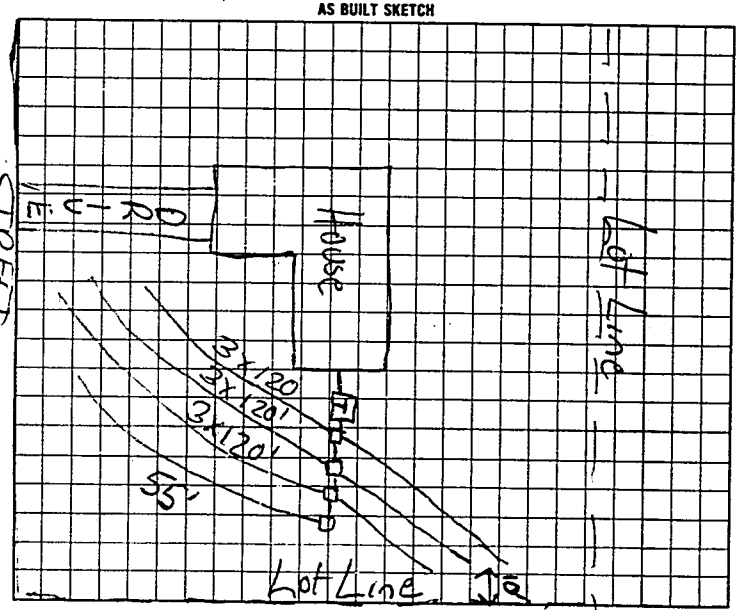

I understand that this permit can be suspended or revoked if any false information is supplied toward securing the permit/any unauthorized changes are made to the site/any unauthorized changes are made in the installation of the system.

Signed: John Moorefield Drop boxes

Improvement Permit by R.C. Moore date 5-11-96

Existing System Information/Authorization to Construct by R.C. Moore date 5-11-96

Installed by: A-1 Backhoe

Certificate of Completion by date

Operation Permit by: date 8/8/96

authorization to construct EXPIRES 60 mos from issue

to County: DEPT COPY WHITE INSPECTION COPY (FINAL) GREEN OWNER COPY (FINAL) YELLOW INSPECTION COPY (INITIAL) PINK OWNER COPY (INITIAL) GOLD