3:00pm

58741

IREDELL COUNTY HEALTH DEPARTMENT

STATESVILLE 704-878-5305 MOORESVILLE 704-664-5281

IMPROVEMENT PERMIT / CERTIFICATE OF COMPLETION / OPERATION PERMIT / EXISTING SYSTEM INSPECTION

PROPERTY DESCRIPTION NO. 22820 DATE 12-18-95 TAX MAP NO. 11C-3-A-5 Watershed: ☐ Yes ☐ No

OWNER OR CONTRACTOR John morefield (welding) PHONE: Business Home 873 7885

ADDRESS 1516 mocksville Hwy

LOCATION 645E TL Hunters Ridge RD Last Part NewSalemRd on Left

SUBDIVISION Hunters Ridge BLOCK / SECTION LOT 5 LOT AREA 165x153 SITE CLASS PS DESIGN FLOW 360 L.T.A.R. .2½

Septic Tank: 1000 Gallons; STB 794 Date 2-26-96

Pump Tank: Gallons; PT Date

Pump Make: Model Serial No.

Nitrification Field: No Fields 1 Square Feet 1050 Linear Feet 350

No Lines 4 Trench Width 36" Max Trench Bottom Depth 36" Gravel Depth N/A

☒ New System ☐ Repair System Type: I, II, III, IV, V, VI

System Description: Gravity chamber trench

Repair System Description: Pump to PDS

Maintenance Agreement Required: ☐ Yes ☒ No

☒ House/Mod. Home No. Bedrooms 3

☐ Mobile Home No. Bathrooms 2

☐ Business No. Employees

☐ Other


☐ Slab ☒ Crawl Space ☐ Basement w/plumbing ☐ Basement wo/plumbing

Water Supply: ☐ Individual ☐ Community ☒ Public

Comments: Equals 460' conv. line.

Comments:

INITIAL SITE SKETCH

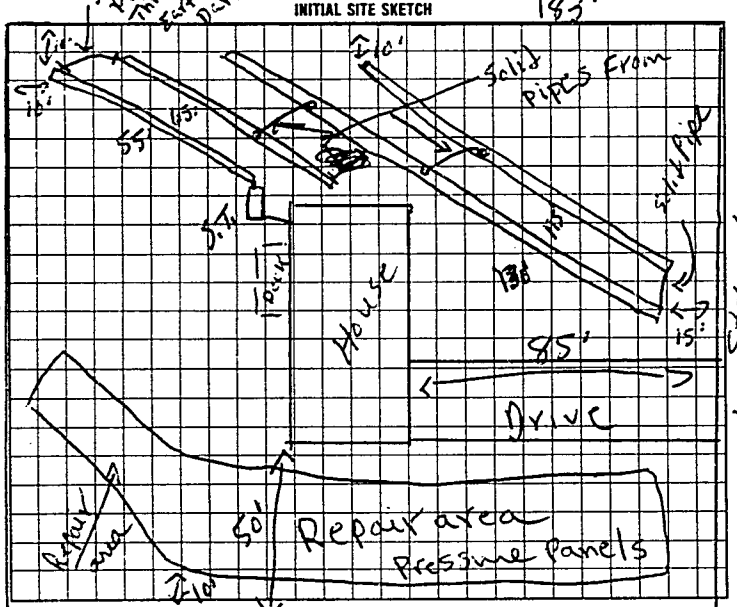

AS BUILT SKETCH

Same as initial sketch

I understand that this permit can be suspended or revoked if any false information is supplied toward securing the permit/any unauthorized changes are made to the site/any unauthorized changes are made in the installation of the system.

Signed John Morefield

Installed by: A-1 Backhoe

Improvement Permit by: L. C. Moore date 12-18-95

Certificate of Completion by: date

Existing System Inspected by: L. C. Moore date 12-18-95

Operation Permit by: L. C. Moore date 4-9-97

further location to const

to co

HEALTH DEPT COPY (WHITE) INSPECTION COPY (FINAL) GREEN OWNER COPY (FINAL) YELLOW INSPECTION COPY (INITIAL) PINK OWNER COPY (INITIAL) GOLD

authorization to const Expires 60 months from

78100