IREDELL COUNTY HEALTH DEPARTMENT

STATESVILLE 704-878-5305 MOORESVILLE 704-664-5281

IMPROVEMENT PERMIT / AUTHORIZATION TO CONSTRUCT / OPERATION PERMIT / EXISTING SYSTEM INSPECTION

PERMIT# 78602 PIN# 4775 35 8616 DATE 1-12-99

OWNER OR CONTRACTOR ~~Jess~~ Whicker PHONE: Business _____ Home 871 0940

ADDRESS 146 Hunters Ridge Ln

LOCATION 64 E TL Hunter Ridge LN at end

SUBDIVISION Hunters Ridge BLOCK / SECTION _____ LOT 11 LOT AREA 4.12 acres SITE CLASS PS DESIGN FLOW 480 L.T.A.R. .33

Septic Tank: 1000 Gallons; STB 1012 Date 11/10/99

Pump Tank: 1000 Gallons; PT 1770 Date 11/10/99

Pump Make: Goulds Model WE1a 1H Serial No K9847492

Nitrification Field: No Fields 1 Square Feet 1080 Linear Feet 360

No Lines 3 Trench Width 36" Max Trench Bottom Depth 36" Gravel Depth N/A

☑ New System ☐ Repair System Type: I, II, III, IV, V, VI

System Description: Pump To 25% Rct.

Repair System Description: " " "

Maintenance Agreement Required: ☐ Yes ☑ No

☑ House/Mod. Home No. Bedrooms 4

☐ Mobile Home No. Bathrooms 3

☐ Business No. Employees _____

☐ Other _____


☐ Slab ☐ Crawl Space ☑ Basement w/plumbing ☐ Basement wo/plumbing

Water Supply: ☐ Individual ☑ Public ☐ Community

Comments/Conditions: See Attached Sheets for P.T. Pressure manifold & clean out setup

Comments/Conditions

INITIAL SITE SKETCH

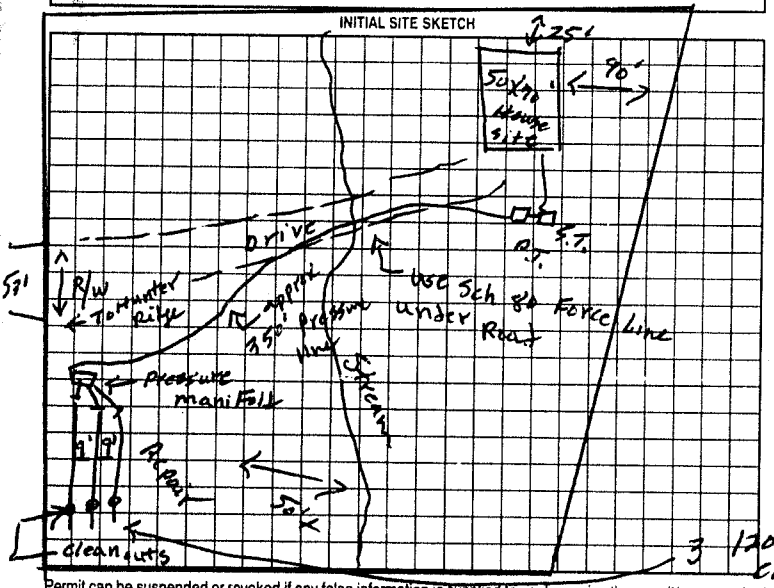

AS BUILT SKETCH

March 8-2000
Typ 2 Lines Installed
w/10 panels each. OK
Pump & Septic Tank - OK
Force Line Sch 40 2" Not in Road

MARCH 9-2000 3rd Line installed correct
- Pump Pressure head Set - OK
- Alarm
- ALARM CHECK 7-24-00

Permit can be suspended or revoked if any false information is supplied toward securing the permit/any unauthorized changes are made to the site/any unauthorized changes are made in the installation of the system. Improvement Permit with plat valid without expiration. Improvement Permit with site plan valid for sixty months. Authorization to Construct is valid for a period equal to that of Improvement Permit – not to exceed sixty months.

Signed: Jeffrey E. Whicker date 1-13-99 Installed by: Steve Jordan

Improvement Permit by: R.C. Moore date 1-12-99 Operation Permit by: STEVE HEDRICK date 7-24-00

Authorization to Construct by: R.C. Moore date 1-12-99 Existing System Inspection by: _____ date _____

HEALTH DEPT COPY: WHITE OWNER COPY (FINAL): YELLOW OWNER COPY (INITIAL): PINK