# IREDELL COUNTY HEALTH DEPARTMENT

11C-A-8 on Computer

STATESVILLE 704-878-5305 MOORESVILLE 704-664-5281

## IMPROVEMENT PERMIT / CERTIFICATE OF COMPLETION / OPERATION PERMIT / EXISTING SYSTEM INSPECTION

PROPERTY DESCRIPTION NO. 21649 DATE 7-24-95 TAX MAP NO. 11K-A-8 Watershed: ☐ Yes ☐ No

OWNER OR CONTRACTOR John Moorefield PHONE: Business _____ Home _____

ADDRESS 1516 Mocksville ~~RD~~ Rd Statesville

LOCATION 64E past New Salem Ch Rd TL Hunters Ridge Lane 2nd lot Rt

SUBDIVISION Hunters Ridge BLOCK / SECTION _____ LOT 9 LOT AREA 29406 sq ft SITE CLASS PS DESIGN FLOW 360 L.T.A.R. .3

Septic Tank: 1000 Gallons; STB 794 Date 8-10-95

Pump Tank: _____ Gallons; PT _____ Date _____

Pump Make: _____ Model _____ Serial No. _____

Nitrification Field: No Fields 1 Square Feet 1200 Linear Feet 400

No Lines 3 Trench Width 36" Max Trench Bottom Depth 30" Gravel Depth 12"

☐ New System ☐ Repair System Type: I, II, III, IV, V, VI

System Description: Conv. Gravity

Repair System Description: Gravity ~~Infiltrator~~

Maintenance Agreement Required: ☐ Yes ☐ No

☐ Slab ☐ Crawl Space ☐ Basement w/plumbing ☐ Basement wo/plumbing

☐ ~~House~~/Mod. Home No. Bedrooms 3

☐ Mobile Home No. Bathrooms 2

☐ Business No. Employees _____


☐ Other _____

Water Supply: ☐ Individual ☐ Community ☐ Public


Comments:

Comments:

INITIAL SITE SKETCH

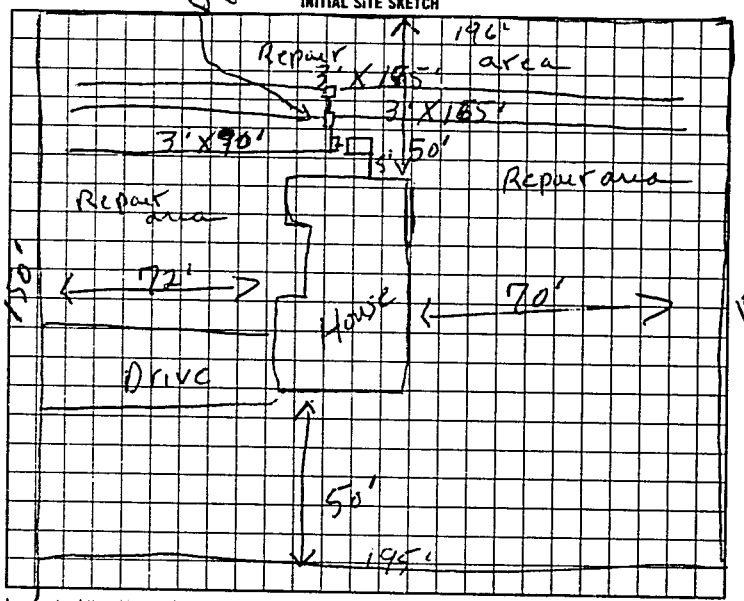


AS BUILT SKETCH

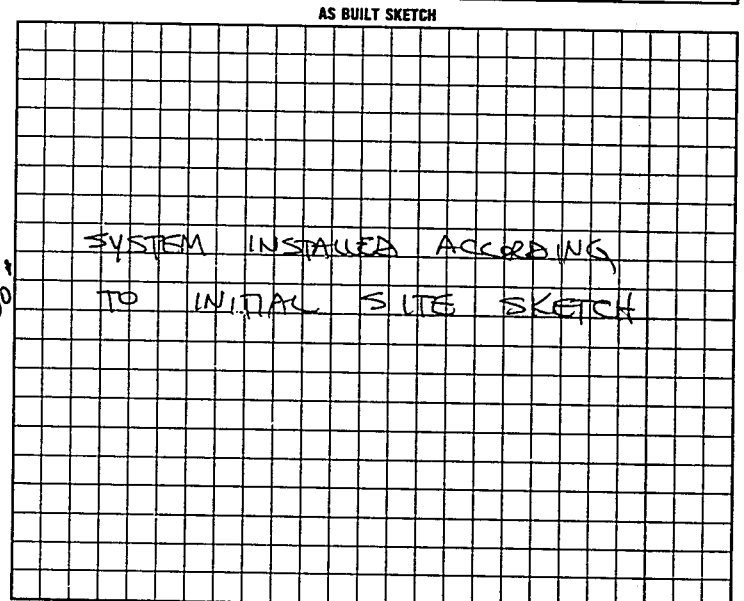


I understand that this permit can be suspended or revoked if any false information is supplied toward securing the permit/any unauthorized changes are made to the site/any unauthorized changes are made in the installation of the system. Improvement Permit is valid for 60 months from date of issuance.

Signed: X John Moorefield

Improvement Permit by: L.C. Moore date 7-24-95

Existing System Inspection by: _____ date _____

Installed by: A-1 BACKHOE

~~Certificate of Completion by~~: _____ date _____

Operation Permit by: STEVE HENDRICK date 10-13-95

HEALTH DEPT COPY WHITE INSPECTION COPY (FINAL) GREEN OWNER COPY (FINAL) YELLOW INSPECTION COPY (INITIAL) PINK OWNER COPY (INITIAL) GOLD