IREDELL COUNTY HEALTH DEPARTMENT

Statesville Office (704) 878-5305 Mooresville Office (704) 660-3625 PERMIT # 222509

IMPROVEMENT PERMIT / AUTHORIZATION TO CONSTRUCT / OPERATION PERMIT / EXISTING SYSTEM

JN # 4775370063

APPLICANT: Stephen Hill APPLICANT ADDRESS: 105 Dewberry Ln Statesville NC

SITE ADDRESS: 105 Dewberry Ln Statesville NC PHONE: 704-657-6798 ALT. PHONE: N/A

SITE DIRECTIONS: 64 E T/L Sain Rd turn Left Dewberry Ln first on left

SUBDIVISION: Salem Park SECTION: M1 LOT # 33 LOT AREA: 0.43ac DESIGN FLOW: Ex L.T.A.R.: Ex

Septic Tank 1000 (gal) STB 7160 Date 8/26/16
Pump Tank (gal) PT Date
Pump Make Model Serial #
Nitrification Fields Ex # Lines Ex Linear Ft: Ex
Trench Width Ex Max. Trench Bottom Depth Ex Gravel Depth


☐ New System ☒ Repair ☐ Expansion System Type: I ☒ II III IV V VI
System Description: Tank
Repair System Description:
Maintenance Agreement Required: ☐ YES ☒ NO
☒ GRAVITY ☐ PRESSURE

☒ Residence No. Bedrooms
☐ Business No. Persons
☐ Other No. Employees
☐ Slab ☐ Crawl Space
☐ Basement w/plumbing ☐ Basement w/o plumbing

Water Supply: ☐ Private ☐ Public ☐ Community

Comments / Conditions: Maintain 15' off any basement cut
Use risers to maintain no greater than 6" of cover

INITIAL SITE SKETCH

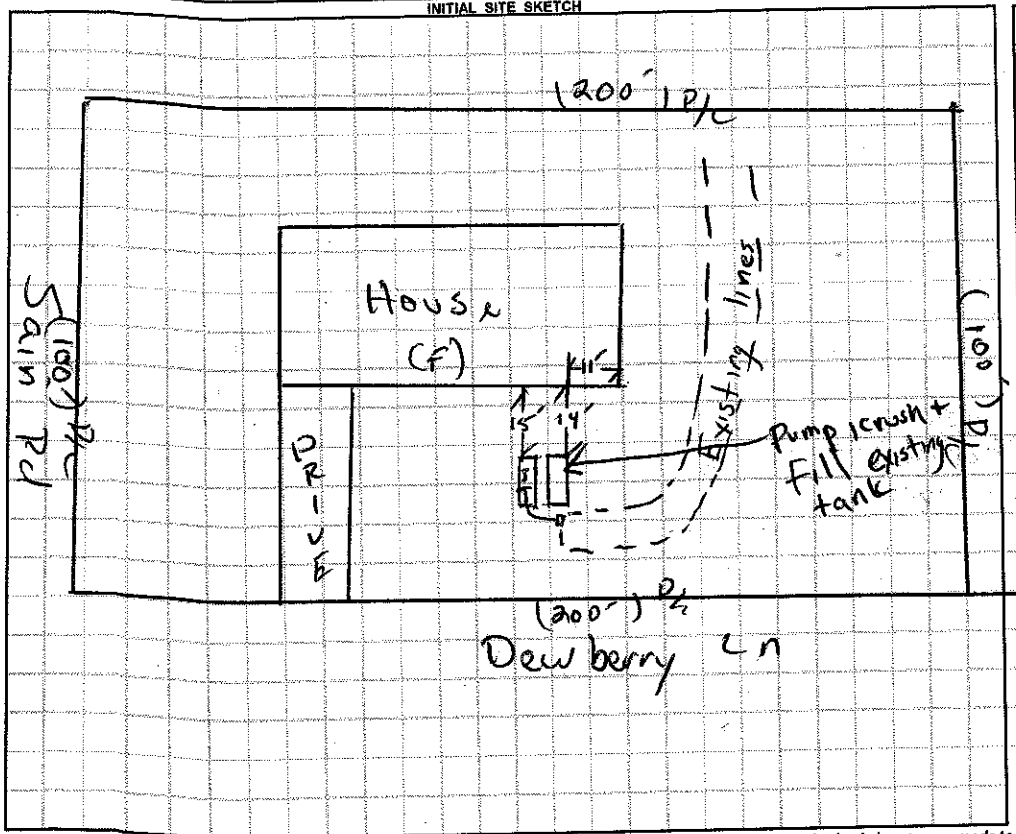

AS BUILT SKETCH

1" = 40'

Permit can be suspended or revoked if any false information is supplied toward securing the permit / any unauthorized changes are made to the site / any unauthorized changes are made in the installation of the system. CONTACT A LOCATOR SERVICE PRIOR TO ANY EXCAVATION

☐ IMPROVEMENT PERMIT with plat valid without expiration. ☒ IMPROVEMENT PERMIT with site plan valid for 60 mos. ☒ AUTHORIZATION TO CONSTRUCT valid for period equal to IMPROVEMENT PERMIT--not to exceed 60 mo.

Owner / Applicant Signature: Stephen Hill Date: 10/21/16 Installed by: Liberty Water Wells

IMPROVEMENT PERMIT by: [signature] Date: 10/21/16 OPERATION PERMIT by: W Sparks Date: 10/27/16

AUTHORIZATION TO CONSTRUCT by: [signature] Date: 10/21/16 Existing System Inspected by: Date:

Health Dept. Copy - WHITE Applicant (Final Approval) - YELLOW Applicant (Conditional Approval) - PINK