IREDELL COUNTY HEALTH DEPARTMENT

STATESVILLE 704-878-5305 MOORESVILLE 704-664-5281

IMPROVEMENT PERMIT / AUTHORIZATION TO CONSTRUCT / OPERATION PERMIT / EXISTING SYSTEM INSPECTION

PERMIT# 72068 PIN# 4775-37-1580 DATE 2-25-98

OWNER OR CONTRACTOR Doug M. Schatte PHONE: Business Home 663-6817

ADDRESS 1316 Superior Dr. Mooresville, N.C.

LOCATION 64 E TL Sain Rd .8mi on left.

SUBDIVISION Salem Park BLOCK / SECTION LOT 37 LOT AREA 1/2 acre SITE CLASS PS DESIGN FLOW 360 L.T.A.R. .3

Septic Tank: 1000 Gallons; STB 760 Date 5-9-98

Pump Tank: Gallons; PT Date

Pump Make: Model Serial No.

Nitrification Field: No Fields 1 Square Feet 1200 Linear Feet 400

No Lines 5 Trench Width 36" Max Trench Bottom Depth 36" Gravel Depth 12"

[x] New System [ ] Repair System Type: [I] II, III, IV, V, VI

System Description: conv. Gravity

Repair System Description: " "

Maintenance Agreement Required: [ ] Yes [x] No

[x] House/Mod. Home No. Bedrooms 3

[ ] Mobile Home No. Bathrooms 2

[ ] Business No. Employees

[ ] Other


[ ] Slab [x] Crawl Space [ ] Basement w/plumbing [ ] Basement wo/plumbing

Water Supply: [ ] Individual [x] Public [ ] Community

Comments:/Conditions:


200'

INITIAL SITE SKETCH

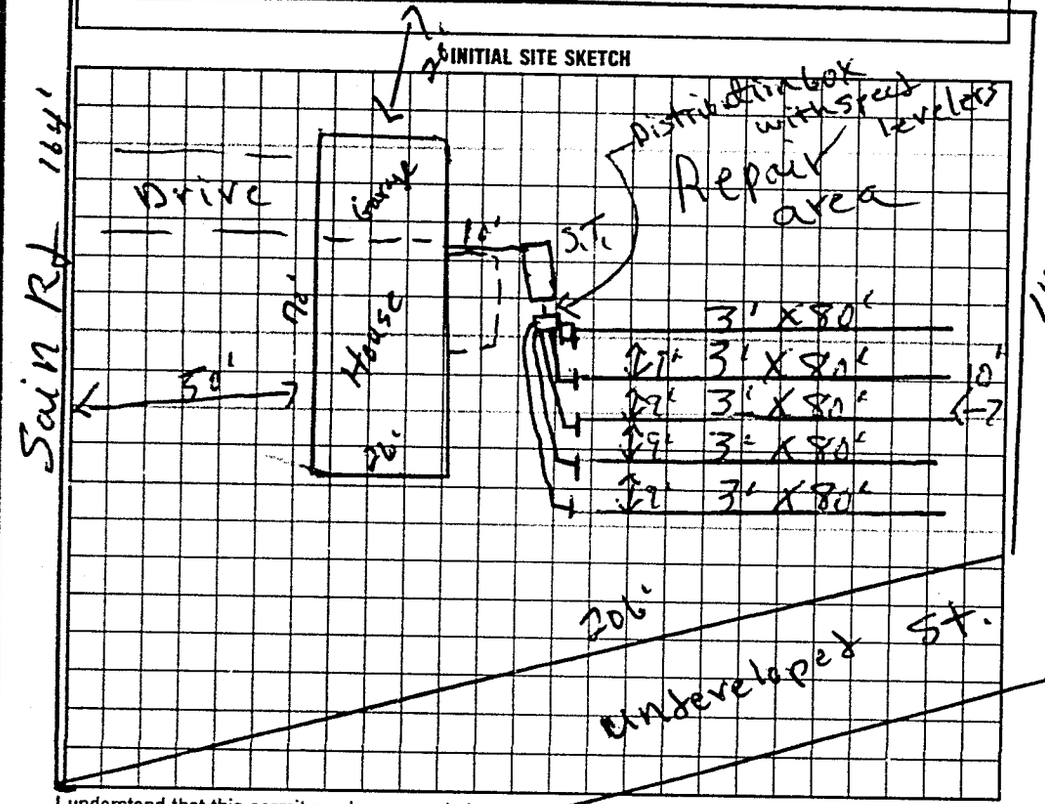

Comments:/Conditions:

AS BUILT SKETCH

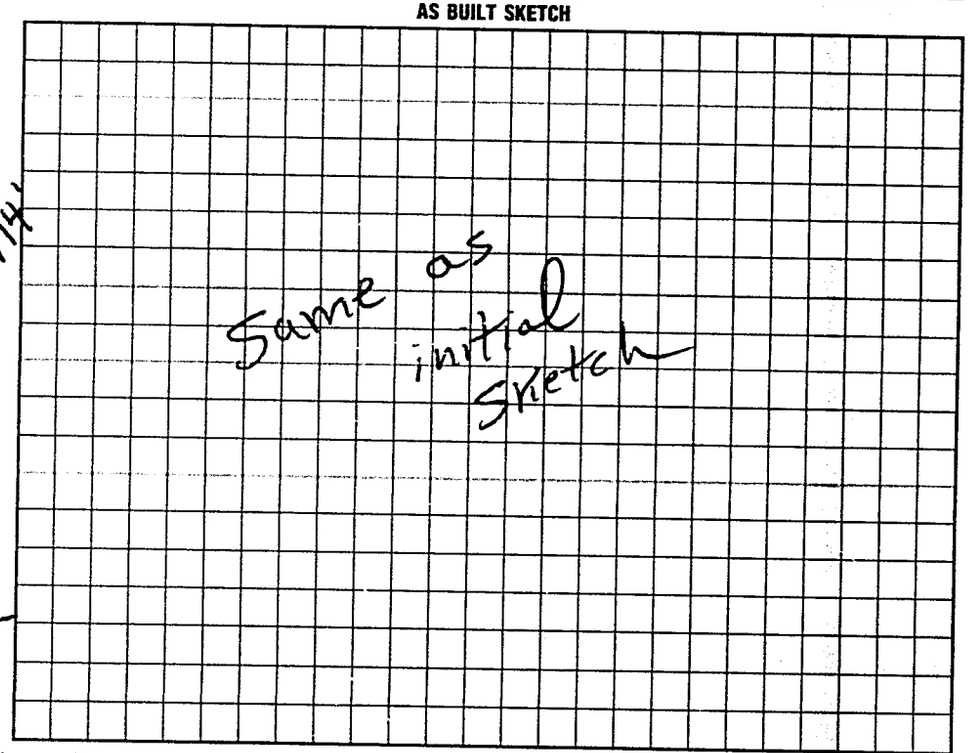

I understand that this permit can be suspended or revoked if any false information is supplied toward securing the permit/any unauthorized changes are made to the site/any unauthorized changes are made in the installation of the system. Improvement Permit with plat valid without expiration. Improvement Permit with site plan valid for sixty months. Authorization to Construct is valid for a period equal to that of Improvement Permit – not to exceed sixty months.

Signed: X Doug M. Schatte date 2-25-98

Improvement Permit by: R.C. Moore date 2-25-98

Authorization to Construct by: R.C. Moore date 2-25-98

Installed by: Barry Sigmon Constr.

Operation Permit by: R.C. Moore date 6-11-98

Existing System Inspection by: date

HEALTH DEPT COPY: WHITE INSPECTION COPY (FINAL): GREEN OWNER COPY (FINAL): YELLOW INSPECTION COPY (INITIAL): PINK OWNER COPY (INITIAL): GOLD