IREDELL COUNTY HEALTH DEPARTMENT

Statesville Phone TR 3-7271 Mooresville Phone NO 3-1271

PERMIT TO INSTALL SEPTIC TANK

Permit NO. _____ Permit Date 7-31-1961

Owner Gaye Chapel Church Address R-4

Installed By Lake Address Rt. 7, City


Location of Property out Winston Hwy to Elmwood & Mills Flower garden rd. - 1st dirt to right - end of rd.

Tank		Capacity		Length of Lines		Fixtures	
Block	( )	800	( )	150'	( )	No. of Baths	2 & tol.
Precast	(✓)	900	( )	175'	( )	Dishwasher	( )
		1000	(✓)	200'	( )	Garbage Grdr.	( )
		1100	( )	225'	(✓)	Auto-Washer	( )
		1200	( )	250'	( )	Other	
		Other		Other			

NOTIFY HEALTH DEPARTMENT AT LEAST EIGHT HOURS BEFORE TANK IS TO BE INSPECTED.

Final Inspection Satisfactory 19__ Approved (✓) Disapproved ( )

Remarks well 100'

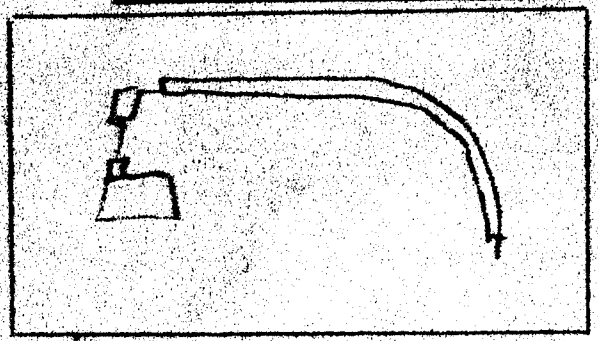

Sketch of Installation well 8

Sanitarian