IREDELL COUNTY HEALTH DEPARTMENT

STATESVILLE 704-878-5305 (ET) MOORESVILLE 704-664-5281

IMPROVEMENT PERMIT / AUTHORIZATION TO CONSTRUCT / OPERATION PERMIT / EXISTING SYSTEM INSPECTION

~~OLD~~ Rd. #155

PERMIT# 104342 PIN# 4775-44-~~5917.B~~ 4974 DATE 05-14-02

OWNER OR CONTRACTOR DONNA DAVENPORT PHONE: Business Home 704-873-2090

ADDRESS 1115 MOCKSVILLE HIGWAY STATESVILLE NC 28625

LOCATION HWY 64 E, ① AT GRAVEL DRIVE B-4 DULL POND & BARRY OAK RD ON RT

SUBDIVISION BLOCK / SECTION LOT LOT AREA 1.5 SITE CLASS. PS DESIGN FLOW 240 L.T.A.R. .125

Septic Tank: 1000 Gallons; STB 1012 Date 9-29-02
Pump Tank: 1000 Gallons; PT 17 Date 7-11-03
Pump Make: Gould Model WE03J11 M Serial No. J0363195
Nitrification Field: No Fields 1 Square Feet EQ=960 Linear Feet 240'
No Lines 3x80' Trench Width 36" Max Trench Bottom Depth 36" Gravel Depth 12"

☒ New System ☐ Repair System Type: I, II, ③ IV, V, VI
System Description: PUMP 25% RED
Repair System Description: PUMP 25% RED
Maintenance Agreement Required: ☐ Yes ☒ No


☒ House/Mod. Home No. Bedrooms 2
☐ Mobile Home No. Bathrooms 2
☐ Business No. Employees
☐ Other
☐ Slab ☐ Crawl Space ☒ Basement w/plumbing ☐ Basement wo/plumbing

Water Supply: ☐ Individual ☒ Public ☐ Community
IREDELL H2O


Comments/Conditions: ① NEW & OLD R/O/W'S TO BE SWITCHED AS SHOWN ON PLAT ② USE PRESSURE MANIFOLD ③ HOUSE & SYSTEM IS FLAGGED OUT COMPLETELY ④ KEEP FRENCH DRAIN 12" DEEPER THAN MAX TRENCH

Comments/Conditions: BOTTOM DEPTH ⑤ MAINTAIN SETBACKS ⑥ PULLED MEASUREMENTS FROM EXISTING IRON ROD AS SHOWN ⑦ PRIOR TO INSTALLATION - CALL FOR PUMP SIZING. - Tuff-Tite filter + ST marker installed

INITIAL SITE SKETCH

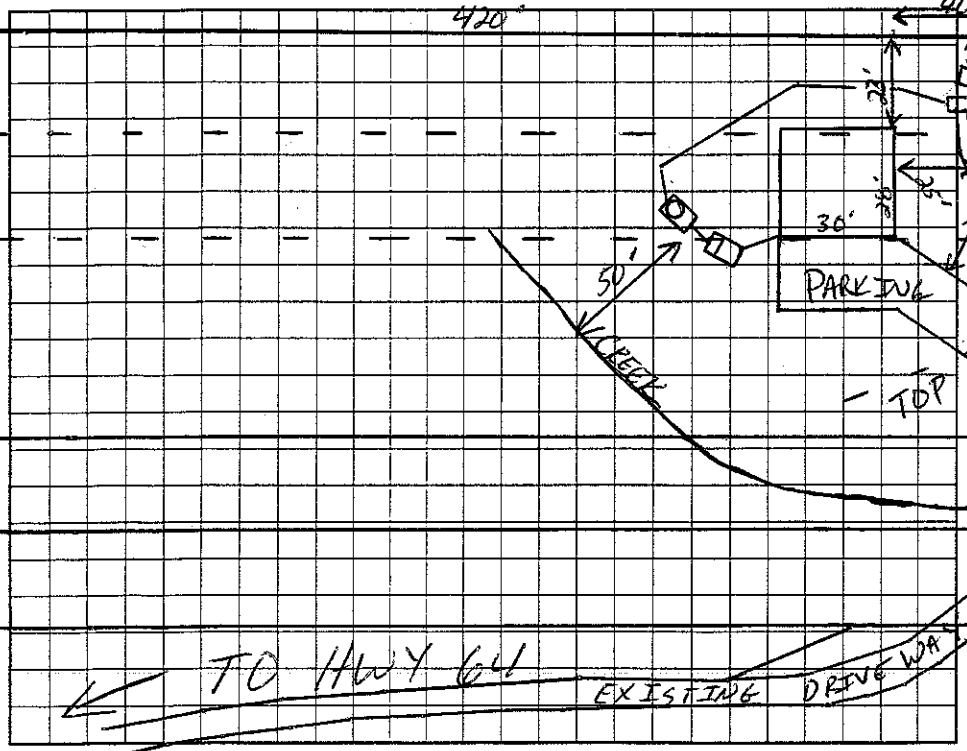

AS BUILT SKETCH - Checked Lines Okay - French Drain Okay 11/13/03

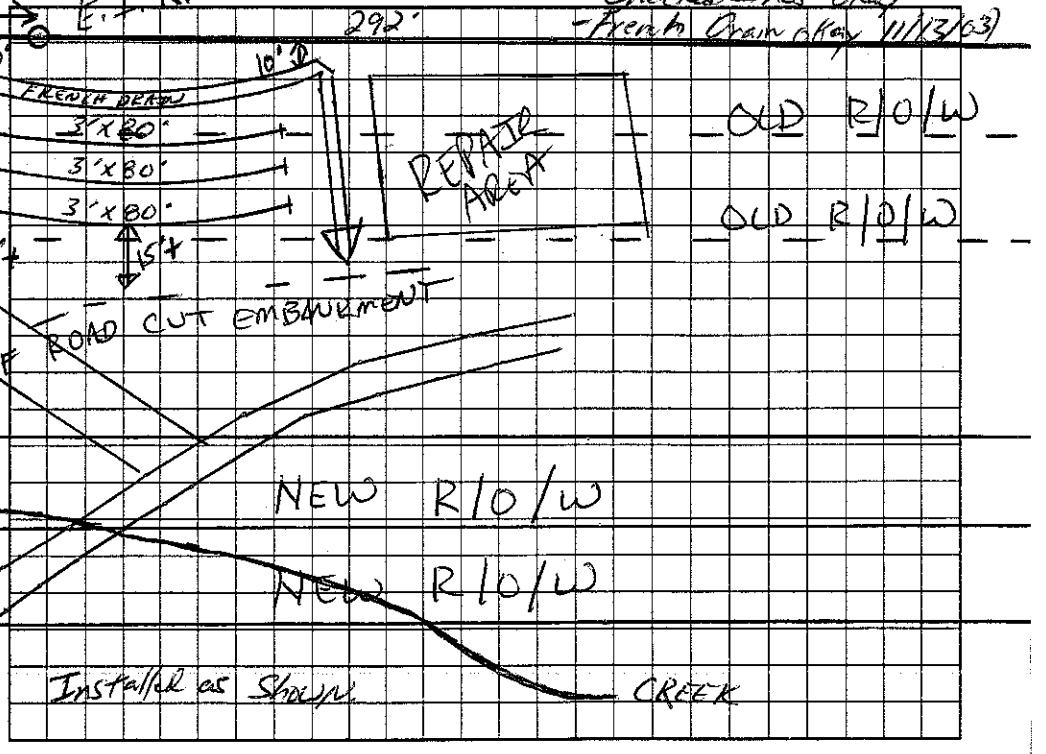

Permit can be suspended or revoked if any false information is supplied toward securing the permit/any unauthorized changes are made to the site/any unauthorized changes are made in the installation of the system. Improvement Permit with plat valid without expiration. Improvement Permit with site plan valid for sixty months. Authorization to Construct is valid for a period equal to that of Improvement Permit – not to exceed sixty months.

Signed: Donna Davenport date 5-14-02 Installed by: Steve Jordan 11/12/03

Improvement Permit by: Tom Cook RS date 05-14-02 Operation Permit by: STEVE HENDRICK date 3-23-04

Authorization to Construct by: Tom Cook RS date 05-14-02 Existing System Inspection by: date

HEALTH DEPT. COPY: WHITE OWNER COPY (FINAL): YELLOW OWNER COPY (INITIAL): PINK